

Name Ahern & Pichette

Service No. 21 267

Address 186 Mass. Ave., Lexington

Location #48 1st House on Forest St. from Mass. Ave.

Kind of Pipe

Size

Size of Main

~~Repair~~ ~~Repair~~ New Service

Location

Date	Material	Amount	Total	Date	Amount
5/1/28	37' 6" Clay Pipe @.30	11 10		Oct 11 1928 Cash	13 28
	1 6" x 1/8" Bend	70			
	Sulphur & Jute	1 48			
		<u>13 28</u>			

Time on water slip

Labor

TOWN OF LEXINGTON—BOARD OF PUBLIC WORKS

SEWER DIVISION

DATE April 14, 1928

NO. \_\_\_\_\_


The undersigned applies for the construction of a particular sewer connecting No. Forest St. Street and hereby agrees to comply with the Rules and Regulations governing the construction and use of Particular Sewers, as now or at any future time established by the Board of Selectmen.

Am't. of Estimate \$ \_\_\_\_\_

Am't. Paid \$ \_\_\_\_\_

*Maurice P. Pabun*  
*Bertha V. Scolette* Owner

Sketch of Service Here

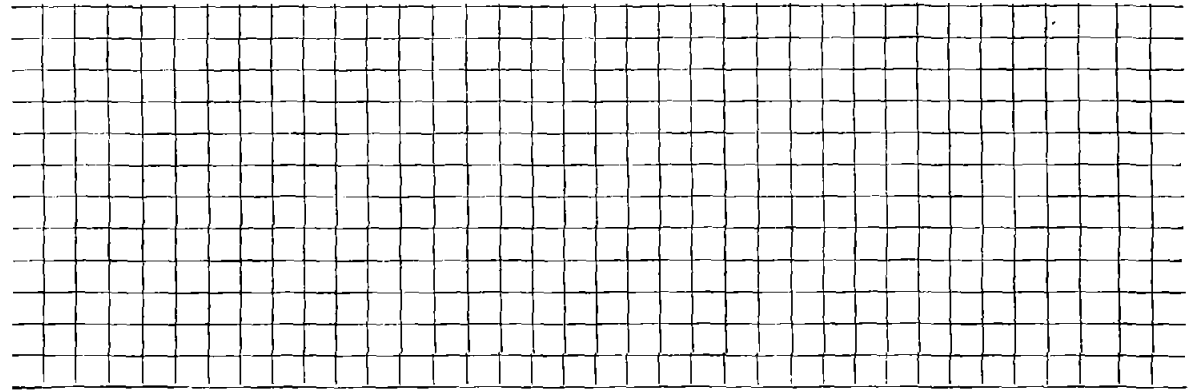

Connection made in \_\_\_\_\_ Street. Work completed \_\_\_\_\_ 19

Remarks: