

Name Ahern & Pichette

Service No. 22 209

Address 186 Mass. Ave.

Location ⁵⁰ 2nd House on Forest St. from Mass. Ave.

Kind of Pipe

Size

Size of Main

~~Repair~~ ~~Renewal~~ - New Service

Location

Date	Material	Amount	Total	Date	Amount
5/1/28	42' 6" Clay Pipe @.30	12 60			
	1 6" x 1/8" Bend	70			
	Sulphur & Jute	1 68	14 98	Oct. 11 1928 - Cash	14 98
	Time on Water Slip				
	Labor				

Hadley Press, Inc., Lexington

TOWN OF LEXINGTON—BOARD OF PUBLIC WORKS

SEWER DIVISION

DATE April 14, 1928.

NO. _____


The undersigned applies for the construction of a particular sewer connecting No. Forest St. Street and hereby agrees to comply with the Rules and Regulations governing the construction and use of Particular Sewers, as now or at any future time established by the Board of Selectmen.

Am't. of Estimate \$ _____

Am't. Paid \$ _____

Maurice J. Pabun
Bertha V. Vichette Owner

Sketch of Service Here

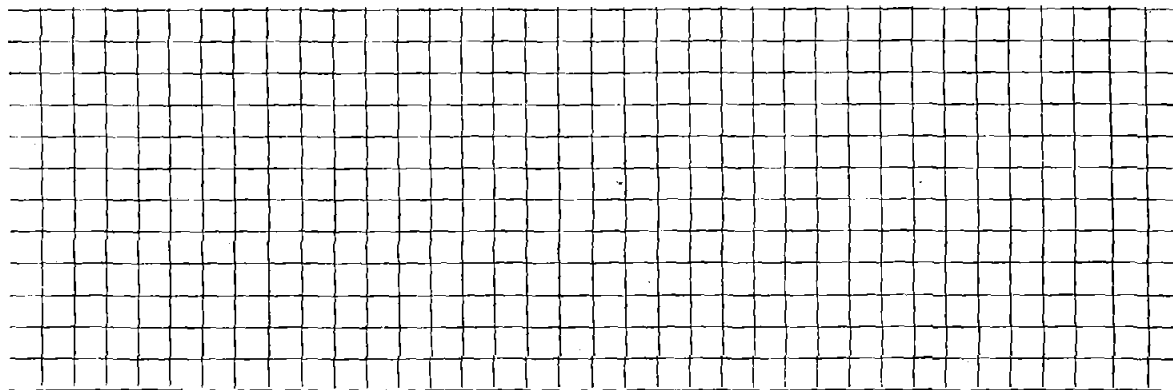

Connection made in _____ Street.

Work completed _____ 19

Remarks: