

Name

Service No.

Address

52 Forrest St

Location

Kind of Pipe

Size

Size of Main

Repair Renewal New Service

Location

Date

Material

Amount

Total

Date

Amount

6.12.01

Inside

29.5' - 6" PVC

4x6 CI to PVC FERNCO

6x6 PVC to PVC FERNCO

6.12.01

Outside

22' - 6" PVC

6x6x6 PVC TEES

2 - 6x6 clay to PVC


FERNCO'S

DATE \_\_\_\_\_

TOWN OF LEXINGTON — BOARD OF PUBLIC WORKS

SEWER DIVISION

Sketch of Service Here

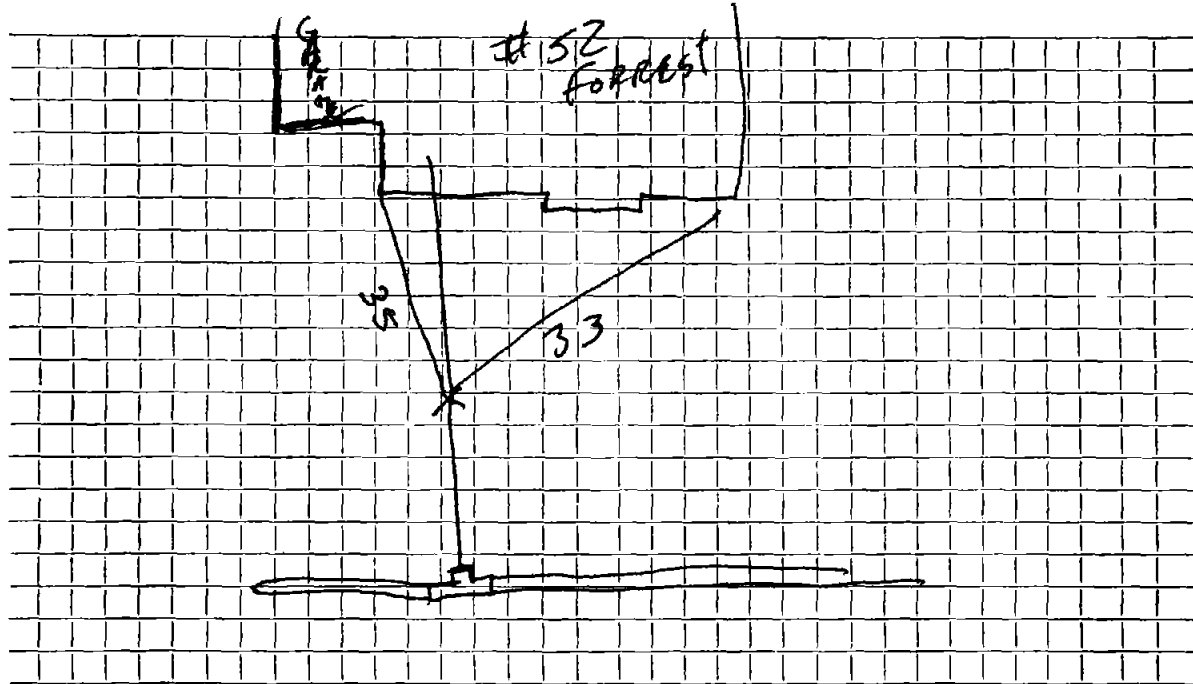

Connection made in ..... Street. Work completed .....

Remarks: Repair made at main - SEWER in same trench as  
water - to left facing house