

Name Merle B. Judkins

Service No. 43 272

Address Grassland Street

Location John F. Daley, ⁵⁴ Forest Street

Kind of Pipe

Size

Size of Main

~~Repair - Renewal~~ - New Service

Location

Date	Material	Amount	Total	Date	Amount
P. 7-12-28 for 15.73	39' 4" Sewer Pipe @.20	7 80		July 20 1925 - Cash	15 73
	10' 4" Iron Pipe @.50	5 00			
	1 4" Bend	70			
	Sulphur & Jute	1 48			
	Trucking	<u>75</u>	15 73		

Hadley Press, Inc., Lexington

6/6/28 Time on Water Slip

Labor

TOWN OF LEXINGTON—BOARD OF PUBLIC WORKS

SEWER DIVISION

DATE June 1, 1928

NO. _____


The undersigned applies for the construction of a particular sewer connecting No. ^{Lot} 90, Forest Street Street and hereby agrees to comply with the Rules and Regulations governing the construction and use of Particular Sewers, as now or at any future time established by the Board of Selectmen.

Am't. of Estimate \$ _____

Am't. Paid \$ _____

John F. Daly Owner
M. B. Paulkins, Builder

Sketch of Service Here

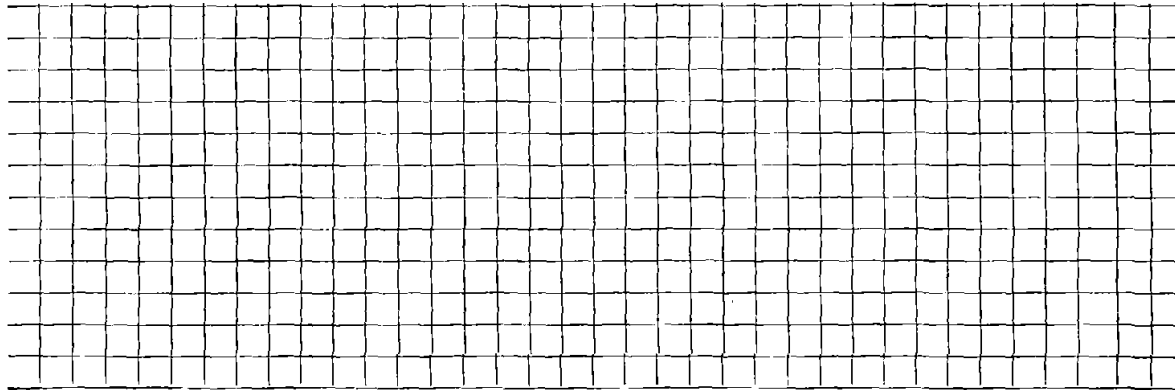

Connection made in _____ Street.

Work completed _____ 19

Remarks: