

Name L. E. Small
 Address Harvard, Massachusetts

Service No. 14 293

Location 55 Forest Street,

Kind of Pipe Size Size of Main

~~Repair-Renewal~~ - New Service

Location

Date 1943	Material	Amount	Total	Date	Amount
July 12	11 hrs. @ 60¢	6 60		June 14, 1943 Deposited	115 00
from 7/26/43	28 " @ 65¢	18 20		July 28, 1943 Refund	32 99
	30 " @ 70¢	21 00			<u>82 01</u>
	8 " @ 80¢	6 40	52 20		
	10% Overhead		5 22		
	40' 6" Sewer Pipe @ 16¢		6 40		
	1/2 bag cement		38		
	Joint compound		2 40		
	2 hrs. compressor @ 2.25		4 50		
	3 " trucking @ 75¢		2 25		
	Trench repairs		8 66		
			<u>82 01</u>		
	Labor				

TOWN OF LEXINGTON—BOARD OF PUBLIC WORKS
SEWER DIVISION

DATE Jan 3 1943

NO. _____


The undersigned applies for the construction of a particular sewer connecting No. 55 Forest St. Street and hereby agrees to comply with the Rules and Regulations governing the construction and use of Particular Sewers, as now or at any future time established by the Board of Selectmen.

Am't. of Estimate \$ 115⁰⁰

Am't. Paid \$ _____

Lawrence E. Small Owner

Sketch of Service Here

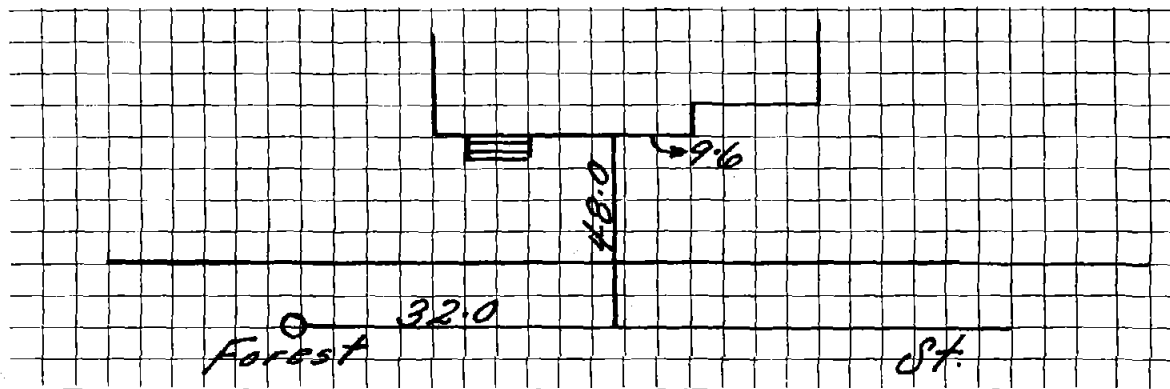

Connection made in _____ Street.

Work completed _____ 19

Remarks: