

Name Mr. Leonard R. Cooke

Service No. 4294

Address 31 Overlook Road, Arlington

Location ⁵⁶
~~94~~ Forest St.

Kind of Pipe

Size

Size of Main

~~Repair~~ ~~Renewal~~ — New Service

Location

Date	Material	Amount	Total	Date	Amount
P. 4-14-31 for 74.75	31' 6" Sewer Pipe @ .25	7 75			
	Sulphur & Jute	1 24			
	Trucking	<u>75</u>	9 74	March 12 1931 Cash	74 75
3/29/31	Hrs. Labor @ .55	36 85		7-28-01	
7	" " @ .60	<u>4 20</u>	41 05		Roots SIDEWALK AREA RESPOND + MEASURE
	15% Overhead		<u>6 16</u>		
			56 95		
April 21 1930	Returned		<u>17 80</u>		
	Labor		74 75		

Hadley Press, Inc., Lexington

TOWN OF LEXINGTON—BOARD OF PUBLIC WORKS

SEWER DIVISION

DATE March 10, 1931

NO. _____


The undersigned applies for the construction of a particular sewer connecting No. 94 Forest St. Street and hereby agrees to comply with the Rules and Regulations governing the construction and use of Particular Sewers, as now or at any future time established by the Board of Selectmen.

Am't. of Estimate \$ 1005

Am't. Paid \$ _____

Leonard R Cooke Owner

Sketch of Service Here

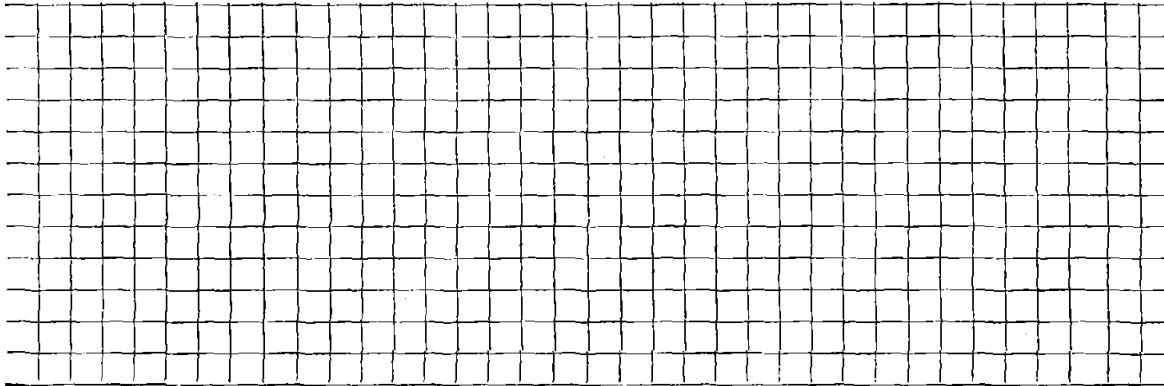

Connection made in _____ Street.

Work completed _____ 19

Remarks: