

Check from:
Name Hazel M. Barry

Owner:
John A. Lappen

Service No. 10 295

Address 16 Vaille Avenue, Lex.

Location 57 Forest Street

Kind of Pipe

Size

Size of Main

Repair—Renewal—New Service

Location

Date
1941

Material

Amount

Total

Date

Amount

June 4,

17 hrs. @ 50¢

8 50

25½ " @ 60¢

15 30

10% Overhead

2 38

42' 6" Sewer Pipe @ 16¢

6 72

Jointing compound

2 52

1½ hrs. compressor @ 2.25

3 38

3 hrs. trucking @ 75¢

2 25

Trench repairs

12 00

53 05

CHARGE: \$53.00

Labor

May 20, 1941 Deposited

53 05

TOWN OF LEXINGTON—BOARD OF PUBLIC WORKS
SEWER DIVISION

DATE 5/20/41

NO. _____


The undersigned applies for the construction of a particular sewer connecting No. 57 Forest Street and hereby agrees to comply with the Rules and Regulations governing the construction and use of Particular Sewers, as now or at any future time established by the Board of Selectmen.

Am't. of Estimate \$ 53.00

Am't. Paid \$ _____

John A. Sapper Owner

Sketch of Service Here

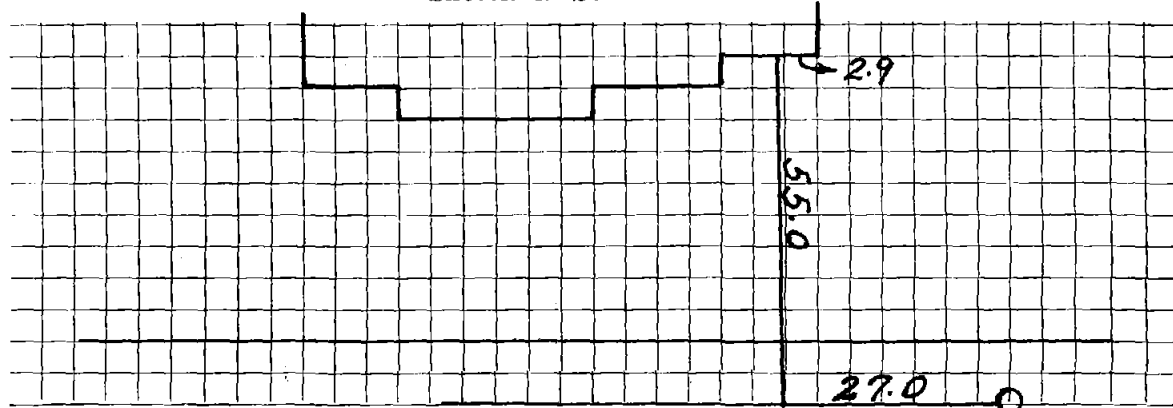

Connection made in _____ Street.

Work completed _____ 19

Remarks:

Handwritten notes:
6' 0" DIA
1' 0" DIA
1' 0" DIA

Handwritten notes:
SAPPER
MAY 20 1941