

Name Leonard R. Cooke
 Address 31 Overlook Road, Arlington

Service No. 29 276

Location Lot #4, Forest St.

Kind of Pipe Size Size of Main
~~Repair - Renewal~~ - New Service Location

Date	Material	Amount	Total	Date	Amount
	42' 6" Sewer Pipe @.30	12 60		<i>July 25-29 Cash</i>	25
	10' 4" Iron " @.50	5 00			
	Sulphur & Jute	1 68			
	Trucking	<u>75</u>	\$20 03		
7/29	4 Hrs. Labor @.60	2 40			
	4 2/3 " " @.55	<u>2 57</u>	4 97		
			\$25 00		
	Balance of labor on water slip				
	Labor				

Haddley Press, Inc., Lexington

TOWN OF LEXINGTON—BOARD OF PUBLIC WORKS

SEWER DIVISION

DATE

June 24, 1929

NO.

Lot # 4

Forest St


The undersigned applies for the construction of a particular sewer connecting No. Forest St Street and hereby agrees to comply with the Rules and Regulations governing the construction and use of Particular Sewers, as now or at any future time established by the Board of Selectmen.

Am't. of Estimate \$ 25⁰⁰

Am't. Paid \$ 25⁰⁰

Leonard R Cooke Owner

Sketch of Service Here

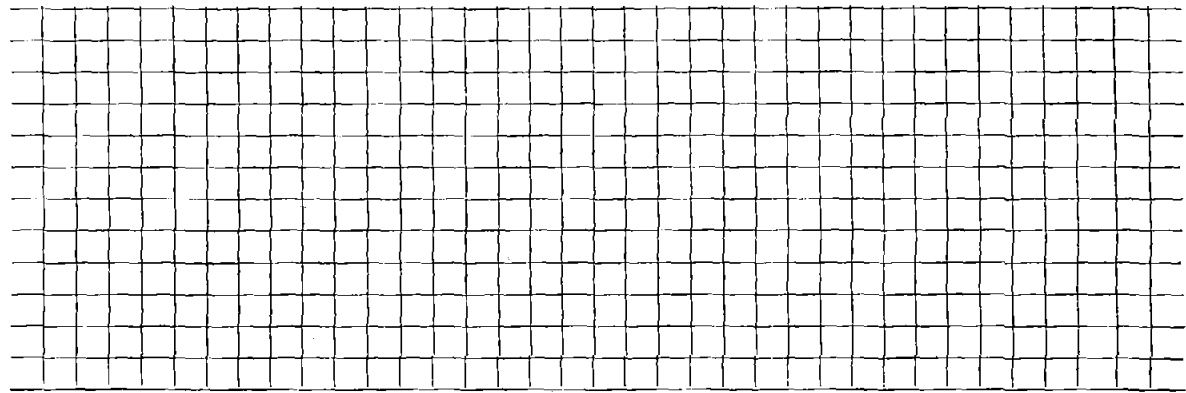

Connection made in _____ Street.

Work completed _____ 19

Remarks: