

Name Marjorie Pierce

Service No. 34<sup>5</sup> 277

Address 59 Forest Street, Lexington

Location Same

Kind of Pipe

Size

Size of Main

~~Repair & Renewal~~—New Service

Location

Date	Material	Amount	Total	Date	Amount
1935 Dec. 3	38 hrs. labor @ 55¢	20 90		Dec 2 1934 Deposited	67 00
	18 " " @ 60¢	<u>10 80</u>		Jan. 18, 1935 Refunded	<u>5 63</u>
			31 70		61 37
	10% Overhead on labor		3 17		
	50' 6"S. Pipe @ 19¢	9 50			
	Sulphur & Jute	2 70			
	1 1/8" Bend	1 80			
	Trucking	2 00			
	3 hrs. comp. @ \$3.50	<u>10 50</u>			
			<u>26 50</u>		
			<u>\$61 37</u>	4-28-34 Solids	
	Labor				

Hadley Press, Inc., Lexington

TOWN OF LEXINGTON—BOARD OF PUBLIC WORKS

SEWER DIVISION

DATE November 30, 1935

NO. \_\_\_\_\_


The undersigned applies for the construction of a particular sewer connecting No. \_\_\_\_\_ Street and hereby agrees to comply with the Rules and Regulations governing the construction and use of Particular Sewers, as now or at any future time established by the Board of Selectmen.

Am't. of Estimate \$ 67.<sup>00</sup>

Am't. Paid \$ \_\_\_\_\_

Marjorie Pierce Owner  
D. F. Jr.

Sketch of Service Here

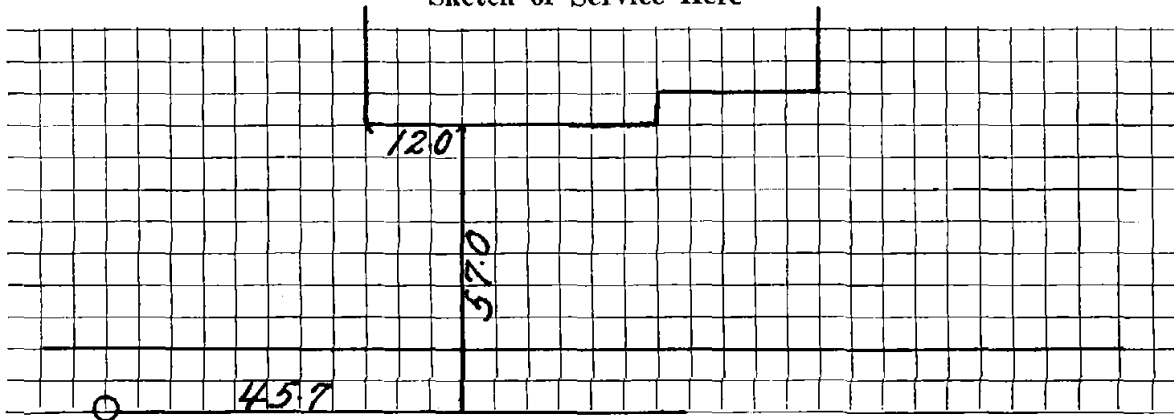

Connection made in \_\_\_\_\_ Street.

Work completed \_\_\_\_\_ 19

Remarks: