


DATE 11/27/89

TOWN OF LEXINGTON — BOARD OF PUBLIC WORKS
SEWER DIVISION

Sketch of Service Here **6A**

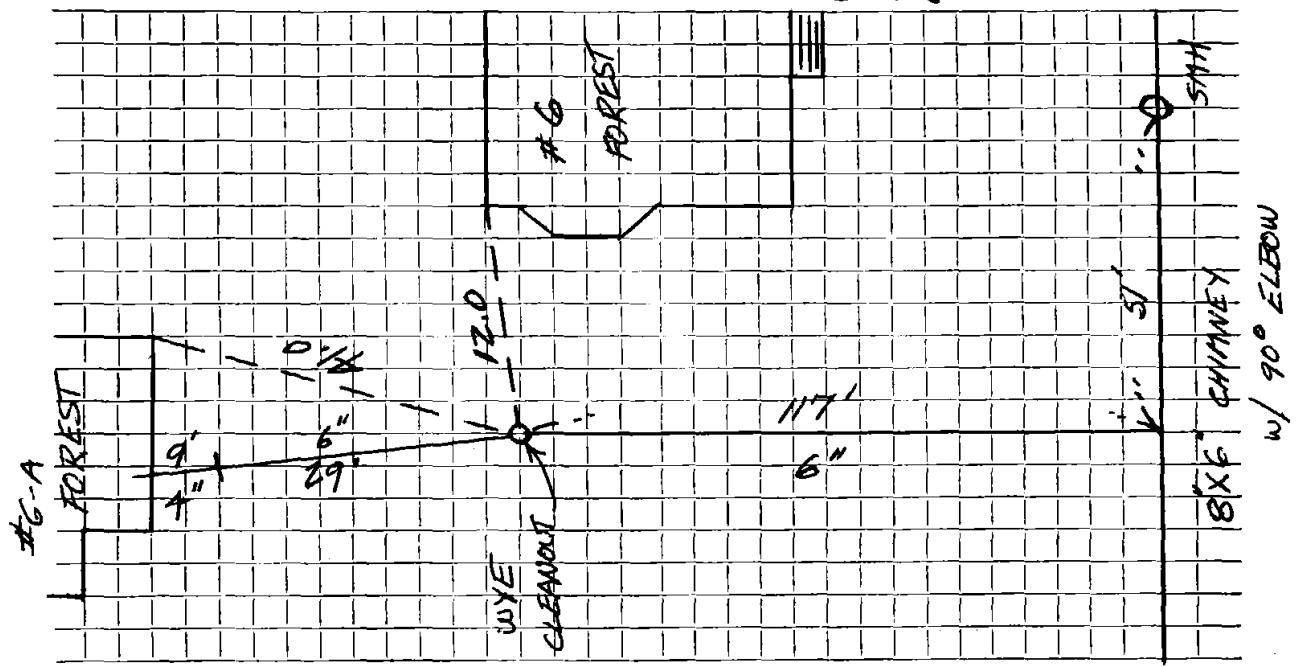

Connection made in Street. Work completed

Remarks: INSPECTION CRG

.....
.....