

Name M. B. Judkins

Service No. 93201

Address Forest Street

Location ~~Forest St~~
Marjorie Pierce

Kind of Pipe

Size

Size of Main

~~Repair~~ ~~Renewal~~ New Service

Location

Date	Material	Amount	Total	Date	Amount
P. 10-22-81 for 2074	38' 6" V.C. Pipe @ .30	11 40			
	10' 4" Iron Pipe @ .50	5 00			
	Sulphur & Jute	1 52			
	Trucking	75	18 67		
10/10/	3 Hrs. Labor @ .60	1 80			
	15% Overhead	27	2 07		
6-22-81	RENEWAL		20 74		
	10' 6" TRANSITE				
	Labor on water slip				
	2 6"-5" TRANSITE nipple				
	1 6"-2" TRANSITE nipple				
	Labor				
	1 6" Fernco Coupling				
	1 6" X 4" DONUT				

Oct. 30 1925 - Cash
6-3-81 RENEWAL
22' 6" P.V.C.

20 74

Handley Press, Inc., Lexington

TOWN OF LEXINGTON—BOARD OF PUBLIC WORKS
SEWER DIVISION

DATE _____

NO. _____


The undersigned applies for the construction of a particular sewer connecting No. _____ Street and hereby agrees to comply with the Rules and Regulations governing the construction and use of Particular Sewers, as now or at any future time established by the Board of Selectmen.

Am't. of Estimate \$ _____

Am't. Paid \$ _____

Owner

Sketch of Service Here **53**

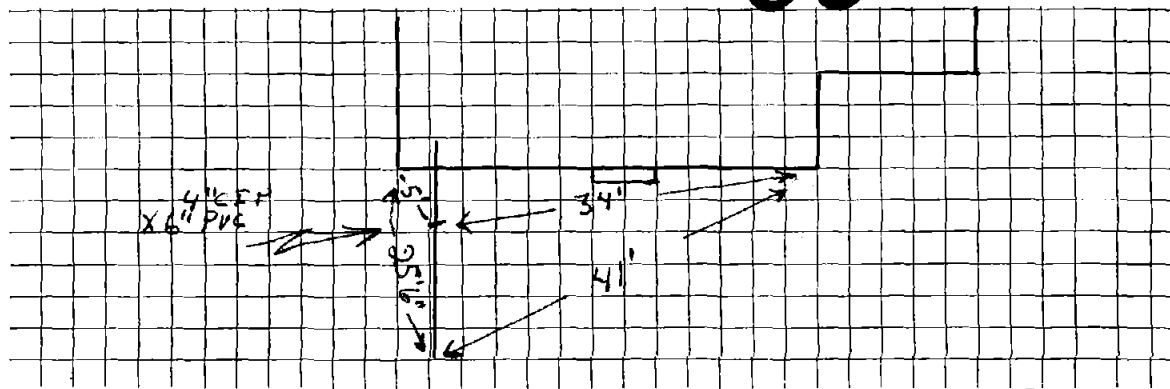

Connection made in _____ Street.

Work completed _____ 19

Remarks: