




DATE \_\_\_\_\_

TOWN OF LEXINGTON — BOARD OF PUBLIC WORKS

SEWER DIVISION

Sketch of Service Here

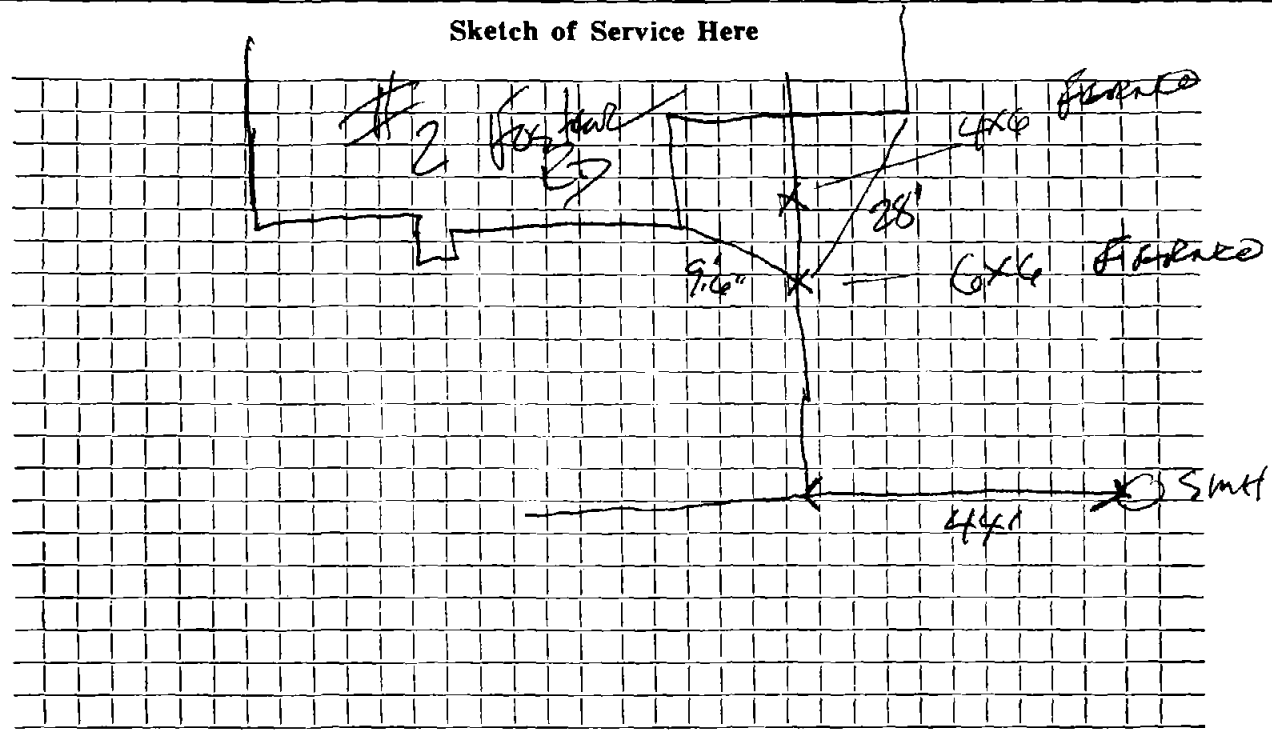

Connection made in \_\_\_\_\_ Street. Work completed .....

Remarks: ..... HOUSE WAS #4 Foster St .....

.....  
.....