

Name Roger T. Westcott

Service No. 220

Address 3 Foster Road

Location

Kind of Pipe

Size

Size of Main

~~Repair Renewal~~—New Service W.O. #7764Location *Corner 5-27-63*


Date	Material	Amount	Total	Date	Amount
4/4/63	Labor 117.04			12-7-62	350 00
4/16/63	" 24.52	141 56		5-27-63	16 12
	10% O.H.	14 16	155 72		333 88
	103' 6" Transite Pipe @ .82		84 46		
	1 8 X 6 Iron Saddle		5 65		
	1 22½° Transite Bend		4 09		
	1 11¼° Transite Bend		4 09		
	2 22½° Elbows @ 2.35		4 70		
	1 90° Transite Elbow		4 09		
	8½ Ton Bank Gravel @ 1.10		9 08		
	24 X 3 Patch		24 00		
	4 Hrs. Town Shovel @ 6.50		26 00		
	3 Hrs. Trucking @ 3.00		9 00		
	1 Hr. Trailer @ 3.00		3 00		
			333 88		

DATE _____

TOWN OF LEXINGTON — BOARD OF PUBLIC WORKS

SEWER DIVISION

Sketch of Service Here **3**

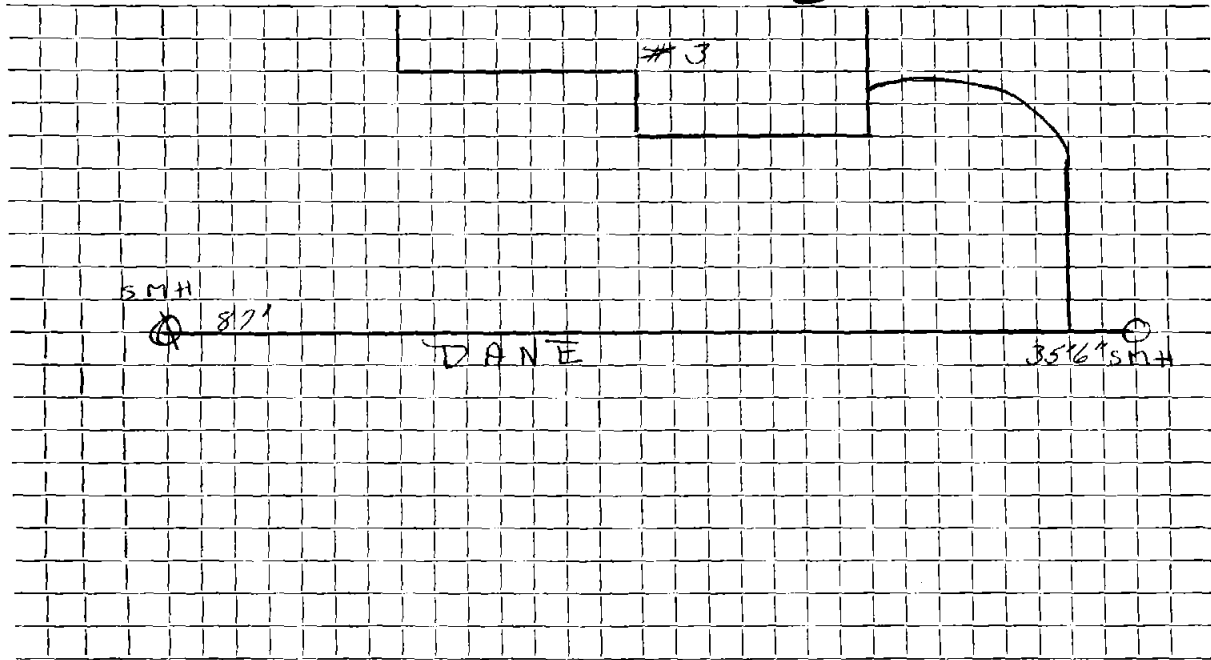

Connection made in Street. Work completed

Remarks:
.....
.....