


DATE APRIL 25 1997

TOWN OF LEXINGTON — BOARD OF PUBLIC WORKS
SEWER DIVISION

Sketch of Service Here

12

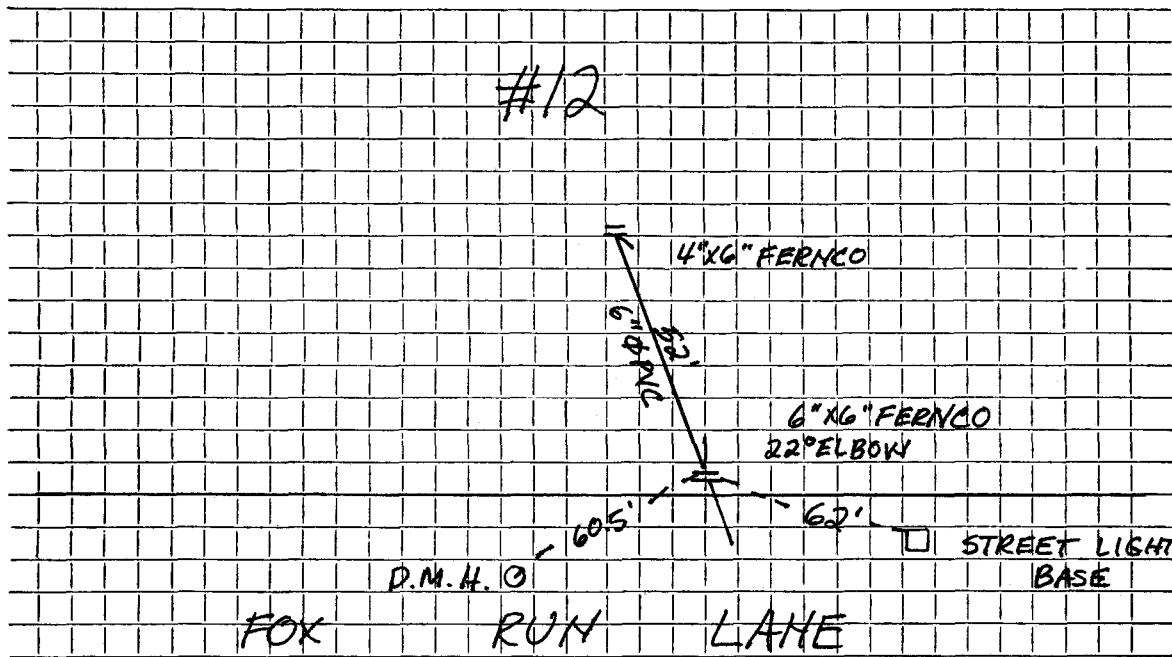

Connection made in FOX RUN LANE Street. Work completed

Remarks: FOUNDATION NOT IN PLACE AT TIME OF INSPECTION.