




DATE 6/6/96

TOWN OF LEXINGTON — BOARD OF PUBLIC WORKS  
SEWER DIVISION

Sketch of Service Here

16

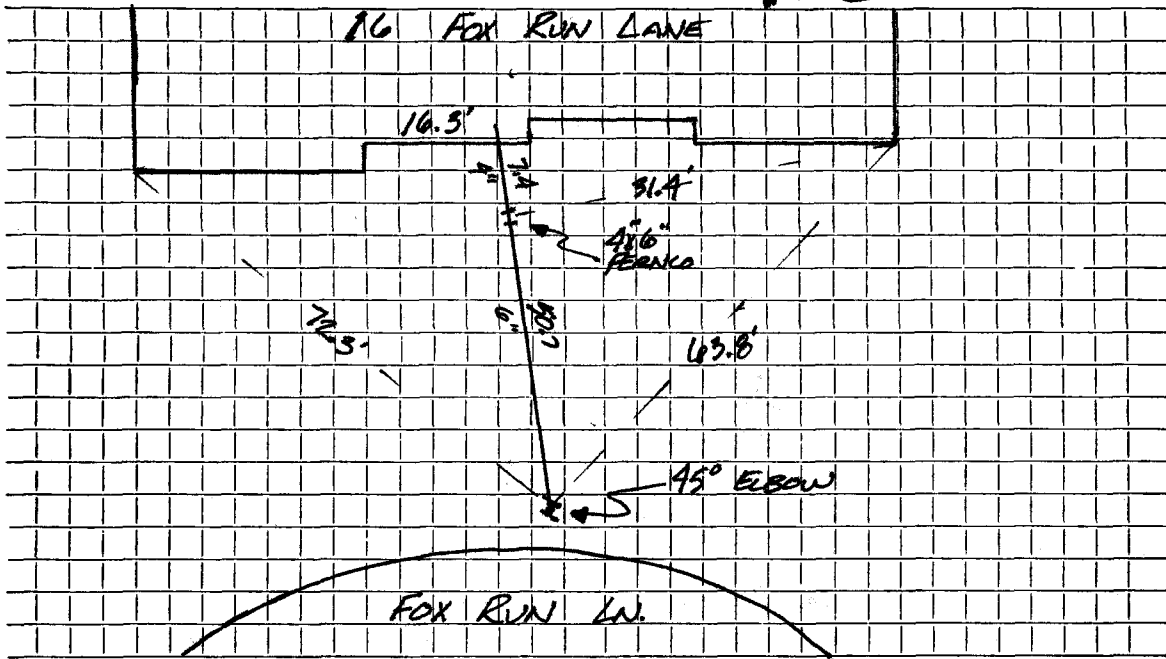

Connection made in ..... Street. Work completed .....

Remarks: .....

.....

.....

BOOK 96-2