




DATE 23 SEPT. 1996

TOWN OF LEXINGTON — BOARD OF PUBLIC WORKS  
SEWER DIVISION

Sketch of Service Here

5

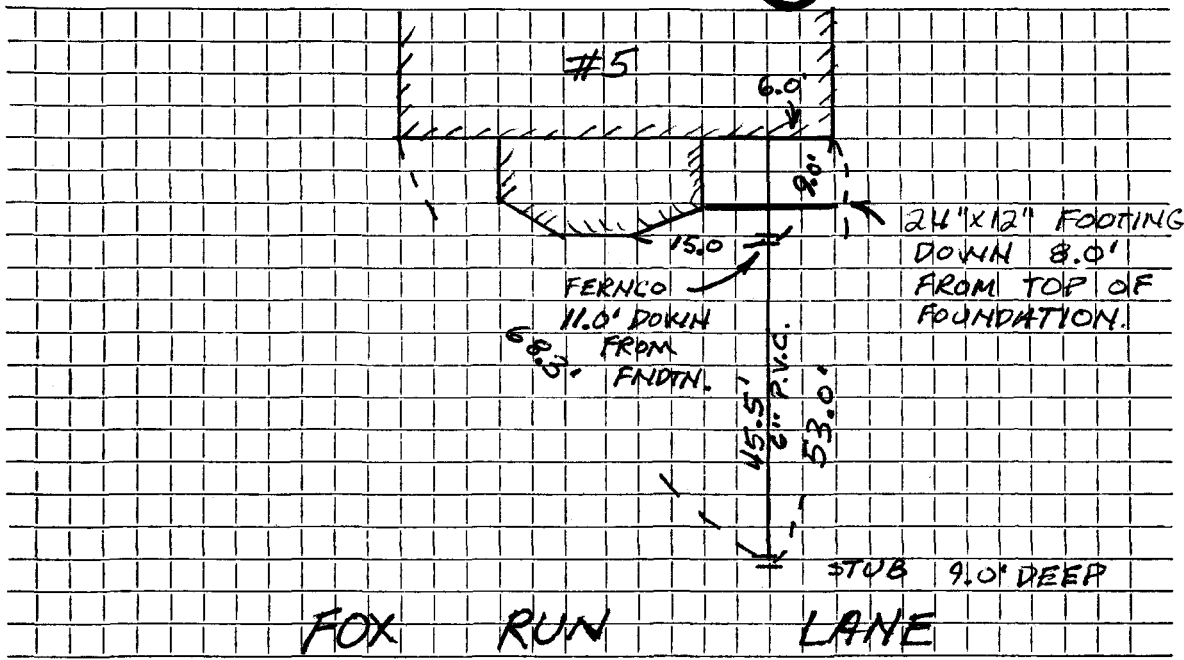

Connection made in FOX RUN LANE Street.

Work completed A. CARDILLO & SONS, INC.

Remarks:

BRICK GULL

I.W.