




DATE 23 SEPT. 1996

TOWN OF LEXINGTON — BOARD OF PUBLIC WORKS  
SEWER DIVISION

Sketch of Service Here

7

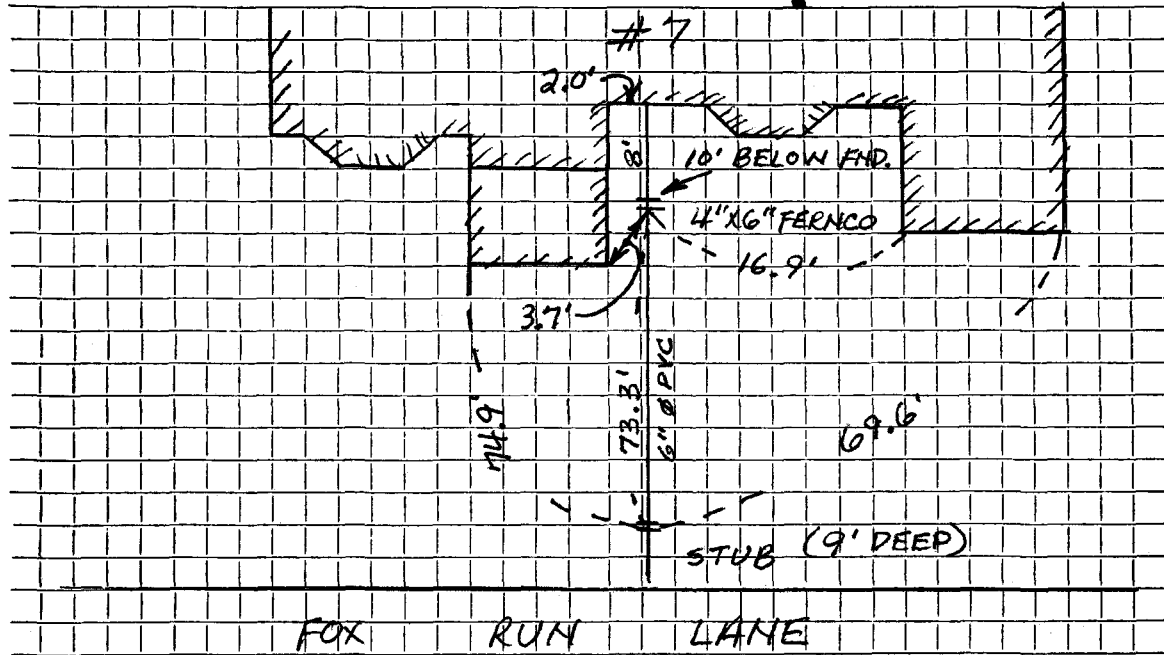

FOX RUN LANE

Connection made in FOX RUN LANE Street. Work completed A. CARDILLO & SONS

Remarks: .....