


DATE JULY 1 1998

TOWN OF LEXINGTON — BOARD OF PUBLIC WORKS
SEWER DIVISION

Sketch of Service Here

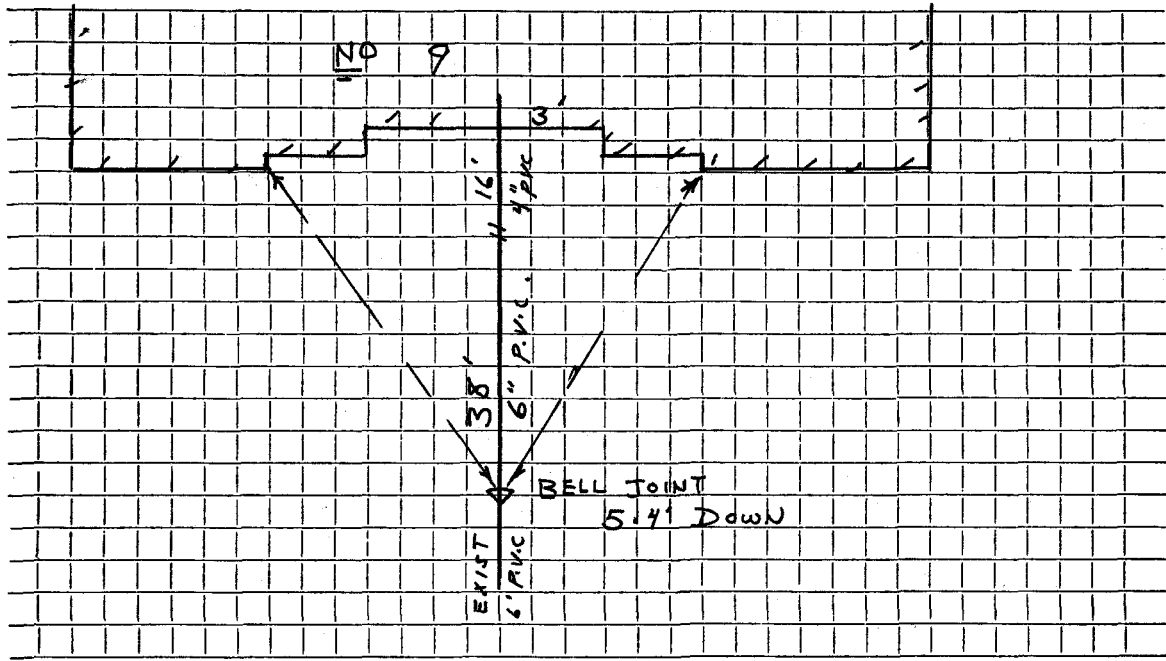

Connection made in FOX RUN LANE Street.

Work completed A. CARDILLO & SONS

Remarks:

..... FIELD BOOK 98-2

..... TSR