

Name Charles H. Murray

Service No. 83

Address 11 Frances Road

Location

Kind of Pipe

Size

Size of Main

~~Repair~~ ~~Renewal~~ New Service


Location Comm 7-17-61

Date	Material	Amount	Total	Date		Amount
7-6-61	Labor	39.53		6-29-61	Deposit	200 00
	10% O.H.	3.93	43.46	7-17-61	Refund	102 78
39'	6" Transite pipe @.78		30.42			<del>102 78</del>
1	11 $\frac{1}{2}$ " Transite Bend		5.10			97 22
1	11 $\frac{1}{2}$ " Transite Elbow		2.24			
2	Hrs. Town Shovel @6.50		13.00			
1	Hr. Trucking @3.00		3.00			
			<u>97.22</u>			

DATE \_\_\_\_\_

TOWN OF LEXINGTON — BOARD OF PUBLIC WORKS  
SEWER DIVISION

Sketch of Service Here

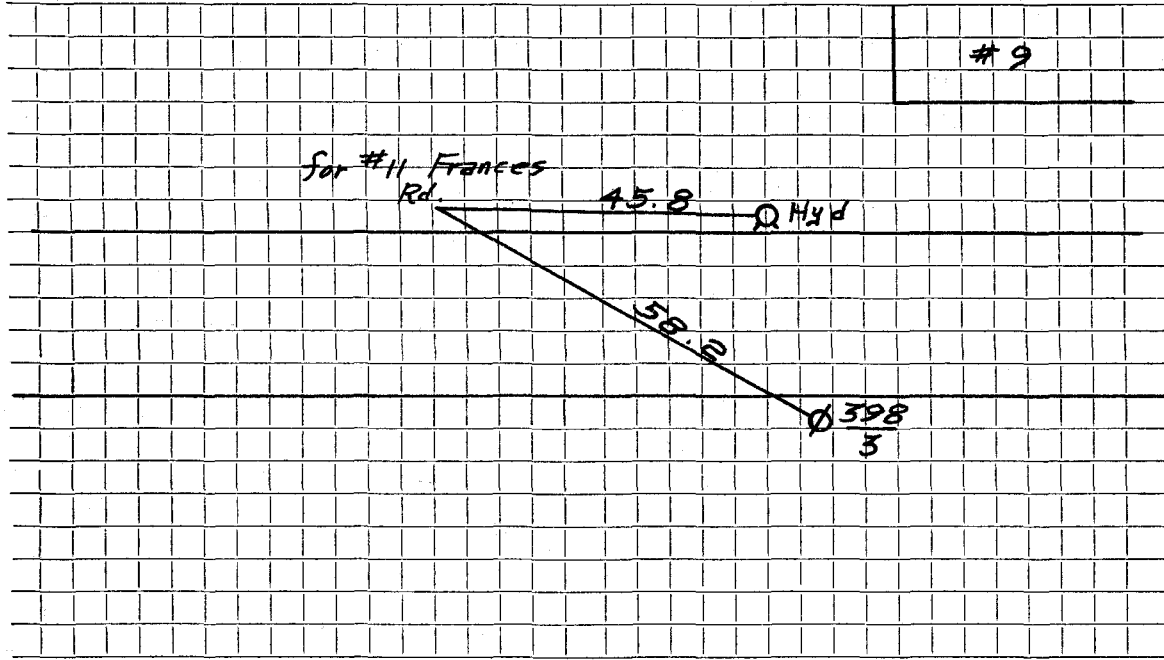

Connection made in ..... Street. Work completed .....

Remarks: .....  
.....  
.....