

Name

Service No.

Address 5 Frances Road

Location

Kind of Pipe

Size

Size of Main

~~Repair~~ Renewal ~~New Service~~

W.O. #9329

Location

| Date | Material | Amount | Total | Date | Amount |
|---------|--|--------|--------|------|--------|
| 11-3-64 | Labor 118.03 | | | | |
| 11-4-64 | " 77.92 | 195.95 | | | |
| | 10% O.H. | 19.60 | 215.55 | | |
| | 35' 6" Transite pipe @.82 | | 28.70 | | |
| | 1 11 ¹ / ₄ " Transite Bend | | 4.09 | | |
| | 1 yd. loam | | 3.00 | | |
| | 5 ton Hot top @5.50 | | 27.50 | | |
| | 3 hrs. Town Truck @3.00 | | 9.00 | | |
| | 1 hr. Tractor | | 6.00 | | |
| | 1 hr. Loader | | 4.00 | | |
| | 1 hr. Compressor | | 5.00 | | |
| | 1 hr. Town Shovel | | 6.50 | | |
| | | | 309.34 | | |

DATE _____

TOWN OF LEXINGTON — BOARD OF PUBLIC WORKS

SEWER DIVISION

Sketch of Service Here

A large grid of graph paper, consisting of 20 columns and 20 rows of small squares, intended for sketching sewer service details.

Connection made in Street. Work completed

Remarks:
.....
.....

Name Herbert McConchie

Service No. XXX 241

Address 5 Francis Road

Location

Kind of Pipe

LEX M.M

Size

Size of Main

~~Repair~~ ~~Renewal~~ New Service

Location

Cam 2-8-60

102-1242
HOME 102-8775

| Date | Material | Amount | Total | Date | Amount |
|----------|---------------------------------|--------|--------|----------|-----------------------|
| 10-24-59 | Labor | 62 24 | | 11-23-59 | 75 00 |
| | 10% O. H. | 6 22 | 68 46 | 2-8-60 | 15 35 |
| 12 | 6" Transite pipe @.70 | | 7 38 | 2-8-60 | 51 06 |
| 12 | Sticks dynamite @.26 | | 3 12 | 5-15-60 | 8 72 |
| 5 | Caps @.28 | | 1 40 | | 150 13 |
| 3 | Hrs. Shovel @6.50 | | 19 50 | | |
| 1 | Hr. Trucking | | 75 | | |
| | | | 100 61 | | |
| | BILL WHEN CONNECTED * | | | | |
| 11-30-59 | Labor | 13 56 | | | |
| | 10% O.H. | 1 36 | 14 92 | | |
| 40' | 6" Transite pipe @.70 | | 28 00 | | |
| 1 | 1 1/2" Transite bend | | 5 10 | | |
| 2 | Hrs. Trucking @.75 | | 1 50 | 11-3-64 | BROKEN PIPE |
| | | | 150 13 | 12-25-64 | Nothing PLUGGED |
| | | | | | BILL sent 2-8-60 8.72 |

**TOWN OF LEXINGTON—DEPT. OF PUBLIC WORKS
SEWER DIVISION**

DATE.....

NO.


The undersigned applies for the construction of a particular sewer connecting No.....
Street and hereby agrees to comply with the Rules and Regulations governing the construction and use of Particular
Sewers, as now or at any future time established by the Board of Selectmen.

Am't of estimate \$.....

Am't Paid \$.....

..... Owner

Sketch of Service Here

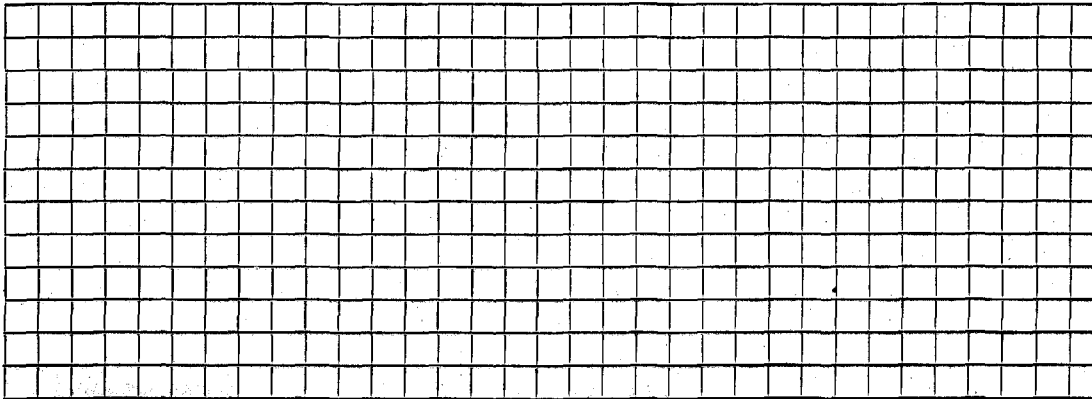

Connection made in..... Street.

Work completed.....19..

Remarks: