

Name Herbert McConchie

Service No. 110

Address 9 Francis Road

Location

Kind of Pipe

Size

Size of Main

~~Repair~~ ~~Renewal~~ New Service

Location Comm 8-1-60

Date	Material	Amount	Total	Date	Amount
0-22-59	Labor	16 32		6-22-60	25 00
	10% O. H.	1 63	17 95	8-1-60	7 56
	10' 6" Transite pipe @.70		7 00		
	1 Hr. Shovel		6 50		
	1 Hr. Trucking		75		
			32 20		
6-23-60	Labor	16 63			
	10% O.H.	1 66	18 29		
	35' 6" Transite pipe @78		27 30		
	1 Hr. pippin Shovel @6.50		6 50		
	1 Hr. Trucking @3.00		3 00	7-10-64	25 95
			87 29	9-	
	Labor			11-5-64	
				Bill sent 8-1-60	4.75

TOWN OF LEXINGTON—DEPT. OF PUBLIC WORKS
SEWER DIVISION

DATE.....

NO.


The undersigned applies for the construction of a particular sewer connecting No.....
Street and hereby agrees to comply with the Rules and Regulations governing the construction and use of Particular
Sewers, as now or at any future time established by the Board of Selectmen.

Am't of estimate \$.....

Am't Paid \$.....

..... Owner

Sketch of Service Here

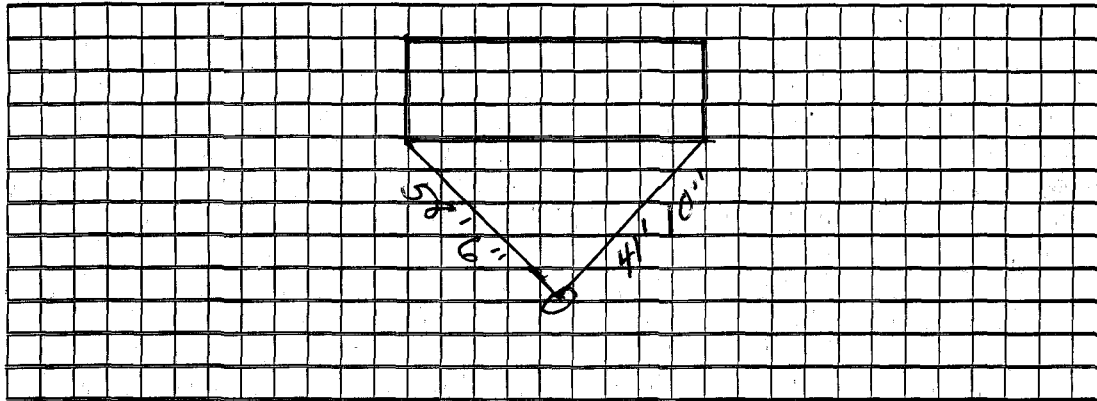

Connection made in..... Street.

Work completed.....19..

Remarks: