

Name

Service No.

Address 3 Franklin Avenue

Location

Kind of Pipe

Size

Size of Main

Repair—Renewal—New Service

Location

Date		Material	Amount	Total	Date		Amount
						NON CHARGE	
					3/4/58	Labor	10 1/4
					5' 6"	Cast Iron Pipe @ 1.96	9 80
					1 Hr	Trucking @ .75	75
							<u>20.99</u>
		Labor					

TOWN OF LEXINGTON—DEPT. OF PUBLIC WORKS
SEWER DIVISION

DATE.....

NO.


The undersigned applies for the construction of a particular sewer connecting No.....
Street and hereby agrees to comply with the Rules and Regulations governing the construction and use of Particular
Sewers, as now or at any future time established by the Board of Selectmen.

Am't of estimate \$.....

Am't Paid \$.....

..... Owner

Sketch of Service Here

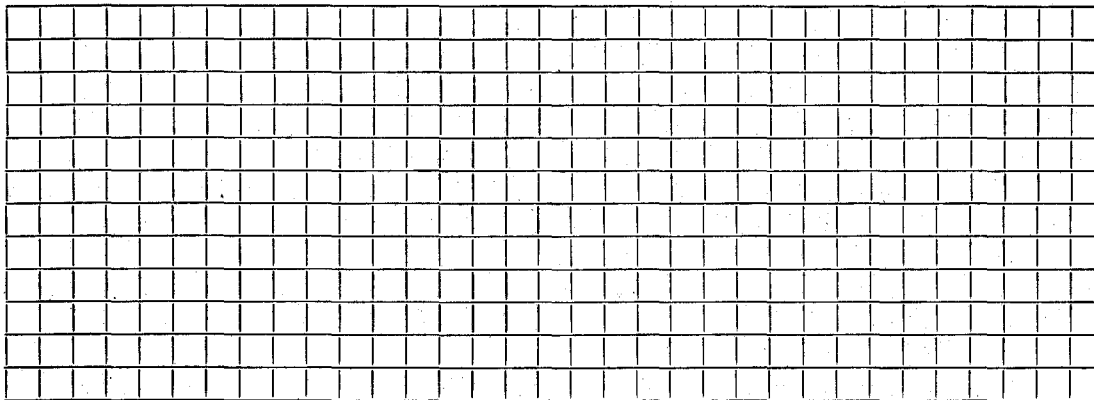

Connection made in..... Street.

Work completed.....19..

Remarks: