

Name John G. Bonfilio, Jr.

Service No. 143

Address 3 Franklin Road

Location

Comm. 11-18-57

Kind of Pipe

Size

Size of Main

~~Repair or Renewal~~—New Service

Installed by contractor

Location

Date

Material

Amount

Total

Date

Amount

9/30

Labor

8-29-57

Deposit

\$ 200 00

10/1/57

"

57 89

11-18-57

Byland

100 82

10% overhead

5 79

NON CHARGE

\$ 99 18

Labor

55 51

63 68

10% overhead

5 55

20' 6" transite pipe @ .70

14 00

Health-welfare

34 42

2 hrs. Northwest shovel @ 6.50

13 00

Northwest shovel

27 00

1 hr Hough @ 3.00

3 00

Hough Loader

48 00

2 hrs. Trucking @ .75

1 50

Trucking

14 50

1 hr pump

1 00

Pump

1 00

1 hr. compressor

3 00

185 98

99 18

Labor

TOWN OF LEXINGTON—DEPT. OF PUBLIC WORKS
SEWER DIVISION

DATE.....

NO.....


The undersigned applies for the construction of a particular sewer connecting No.....
Street and hereby agrees to comply with the Rules and Regulations governing the construction and use of Particular
Sewers, as now or at any future time established by the Board of Selectmen.

Am't of estimate \$.....

Am't Paid \$.....

..... Owner

Sketch of Service Here

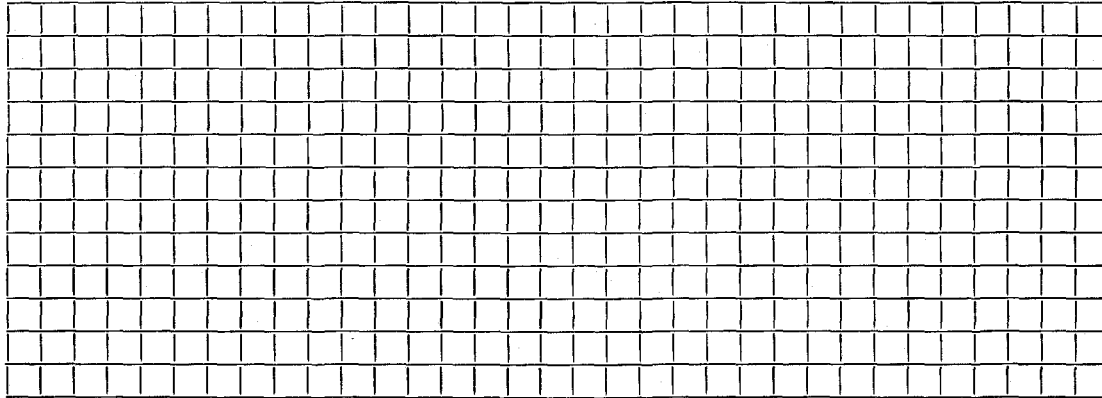

Connection made in..... Street.

Work completed.....19..

Remarks:

Name Stanley Phalen

Service No. 43

Address 3 Franklin Road

Location

Kind of Pipe

Size

Size of Main

~~Repair-Renewal~~ - New Service

Comm - 9-24-56

Location

Date	Material	Amount	Total	Date	Amount
5/9/56	Labor	17 10		5-4-56	Deposit
5/10/56	"	131 57		9-24-56	Refund *
		148 67			
	10% overhead	14 87	163 54		
	126' - 6" Sewer pipe @ .435		54 81		
	Joint compound @ 8.50		7 56		
	8 2/3 hrs. Littlefield Shovel		73 66		
	10x3 patching		10 00		
	33 ton 1 1/4" Stone @ 1.40		46 20		
			355 77		
	Labor				

TOWN OF LEXINGTON—DEPT. OF PUBLIC WORKS

SEWER DIVISION

DATE

NO.

The undersigned applies for the construction of a particular sewer connecting No.
Street and hereby agrees to comply with the Rules and Regulations governing the construction and use of Particular
Sewers, as now or at any future time established by the Board of Selectmen.

Am't of estimate \$.....

Am't Paid \$.....

..... Owner

Sketch of Service Here

Grid area for sketching service details.

Connection made in Street.

Work completed 19..

Remarks: