

Name **Neade, Inc.**

Service No. **3**

Address **5 Franklin ~~Street~~
Road
Lexington**

Location

Kind of Pipe

Size

Size of Main

~~REPAIR WORK~~ New Service

COM. 2-25-52

Location

Date	Material	Amount	Total	Date	Amount
/11/52	Labor	23 94		2-7-52	Deposited 150 00
/11/52	"	44 46		3-10-52	Paid 103 28
/13/52	"	33 45	101 85		253 28
	10% overhead		10 19		
	120' - 6" sewer pipe @ .342		41 04		
	joint compound		7 20		
	10 hrs. Littlefield shovel @ .70		70 00		bill sent 2-25-52
	4 hrs. trucking @ .75		3 00		
	patching 20 x 3		20 00		
			253 28		
				6/2/70	Soldo
	Labor				

TOWN OF LEXINGTON—DEPT. OF PUBLIC WORKS

SEWER DIVISION

DATE

NO.


The undersigned applies for the construction of a particular sewer connecting No. Street and hereby agrees to comply with the Rules and Regulations governing the construction and use of Particular Sewers, as now or at any future time established by the Board of Selectmen.

Am't of estimate \$.

Am't Paid \$.

..... Owner

Sketch of Service Here

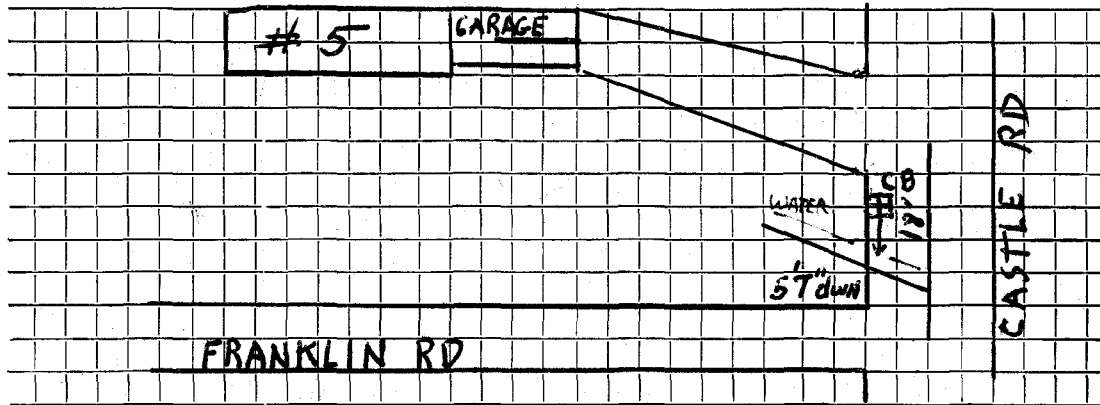

Connection made in CASTLE RD-Transite in Street.

Work completed 19..

Remarks: