

Name Moore Homes Inc.

Service No. 138

Address 6 Franklin Road

Location

Kind of Pipe

Size

Size of Main

Repair—Renewal—New Service

W.O. #7150 DeFlice Bros #1511

Location DEC 22 1969


Date	Material	Amount	Total	Date	Amount
12/5/69	Labor	39.40			
12/9/69	"	14.05	53.45	10-25-69	Deposit 235.00
	10% O.H.	5.35	58.80	12-22-69	Refund 134.56
20'	6" Transite pipe @.88		17.60		110.44
1	22½ Sweep		5.09		
2	ton Hot Top @5.85		11.70		
1½	hrs. Trucking @3.00		4.50		
½	hrs. Trucking @1.50		.75		
1	hr. Shovel		6.50		
½	hr. Loader @4.00		2.00		
½	hr. Roller @3.00		1.50		
	Trailer		2.00		
			110.44		
12-5-69	34' 6" Transite pipe				
	10' 4" Cast Iron pipe				

DATE _____

TOWN OF LEXINGTON — BOARD OF PUBLIC WORKS

SEWER DIVISION

Sketch of Service Here **6**

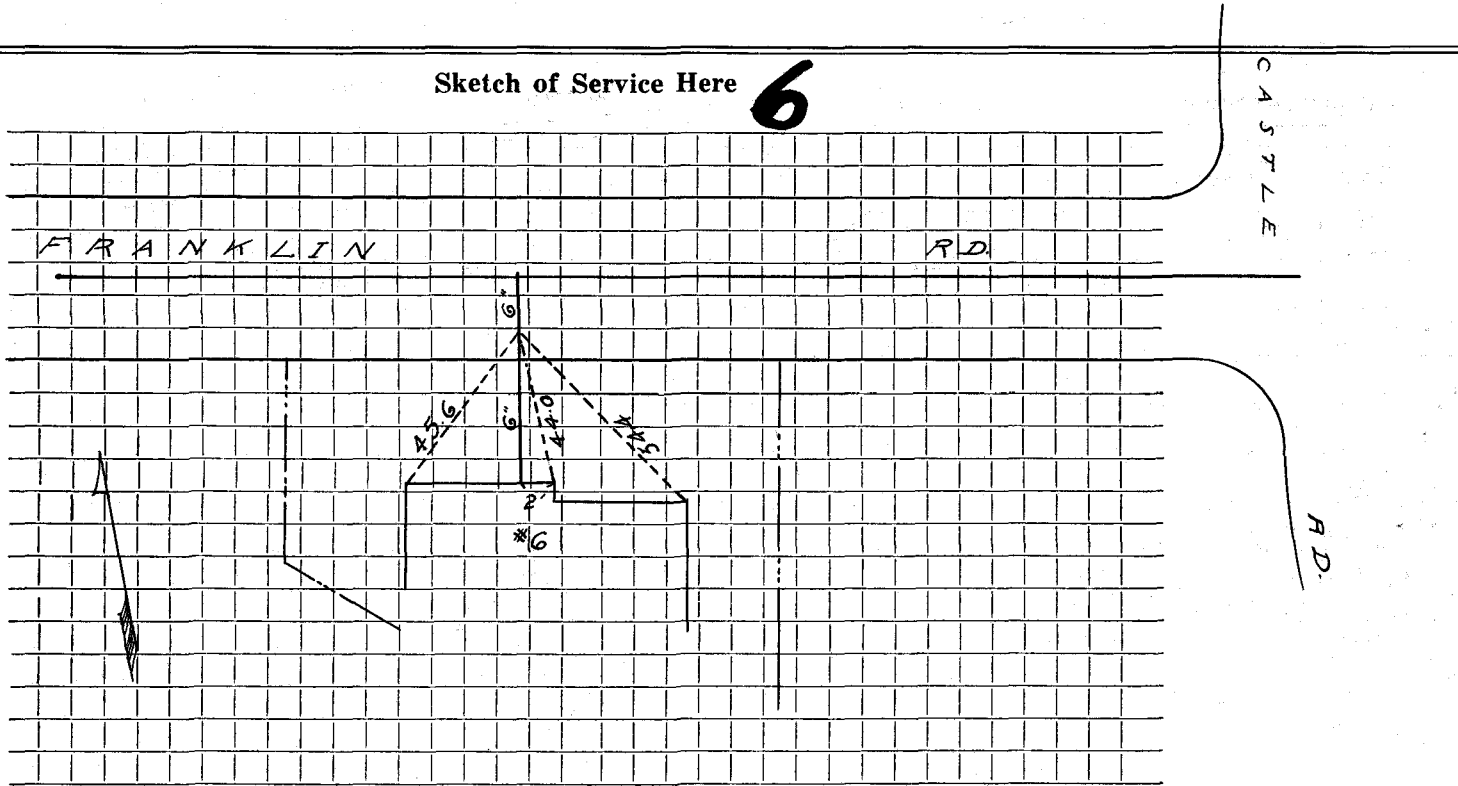

Connection made in Street. Work completed

Remarks:
.....
.....