

Name

Service No.

Address

9 Franklin

Location

Kind of Pipe

SDR Sch. 35 PVC

Size

6"

Size of Main

Repair

~~Renewal~~

New Service

Location

Date

Material

Amount

Total

Date

Amount

6/14/21

6" SDR 35 PVC


6" Cleanout

6" Fernco

DATE 6/14/21

TOWN OF LEXINGTON — BOARD OF PUBLIC WORKS
SEWER DIVISION

Sketch of Service Here

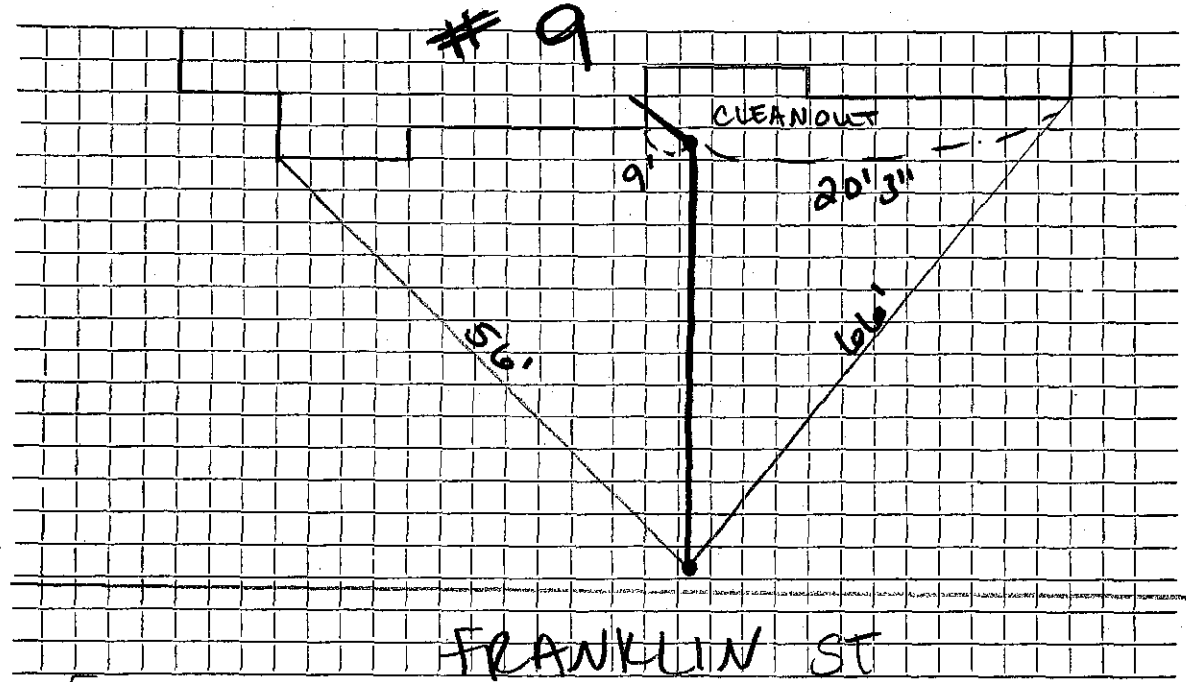

Connection made in Franklin Street. Work completed

Remarks:

.....

.....