

Name L.W. Mead

Service No. 131

Address Franklin Road

Location

Kind of Pipe

Size

Size of Main

~~Repair/Renewal~~ New ServiceDave Eagle # 1984
W. O. # 8363 Extended sewer main

Location

APR 26 1972


Date	Material	Amount	Total	Date	Amount
12/27/71	Labor	129 57		12-30-71	760 00
28/71	"	102 56	232 13		
	10% O.H.		23 21	4-26-72	174 70
29'	8" Transite pipe 1.15		33 35		585 30
3	Rings .68		2 04		
1	Coupling		1 51		
4	Bags cement 1.98		7 92		
6	Ton 3/4" Stone 1.75		10 50		
210	Brick .07		14 70		
1	8" Cap		2 44		
1	5' Precast Manhole		93 75		
1	Se ^{wer} Manhole Frame & Cover		49 50		
2	Ton Cold Patch 8.00		16 00		
5	Ton Hot Top 7.45		37 25		
5	Hrs. Trucking 3.00		15 00		
6	Hrs. Shovel 6.50		39 00		
2	Hrs. Mixer 4.00		2 00		
1	Hr. Loader		5 00		
			585 30		
2-23-72	310' 8" Transite pipe				
	6' 6" Cast Iron pipe				

DATE _____

TOWN OF LEXINGTON — BOARD OF PUBLIC WORKS

SEWER DIVISION

Sketch of Service Here

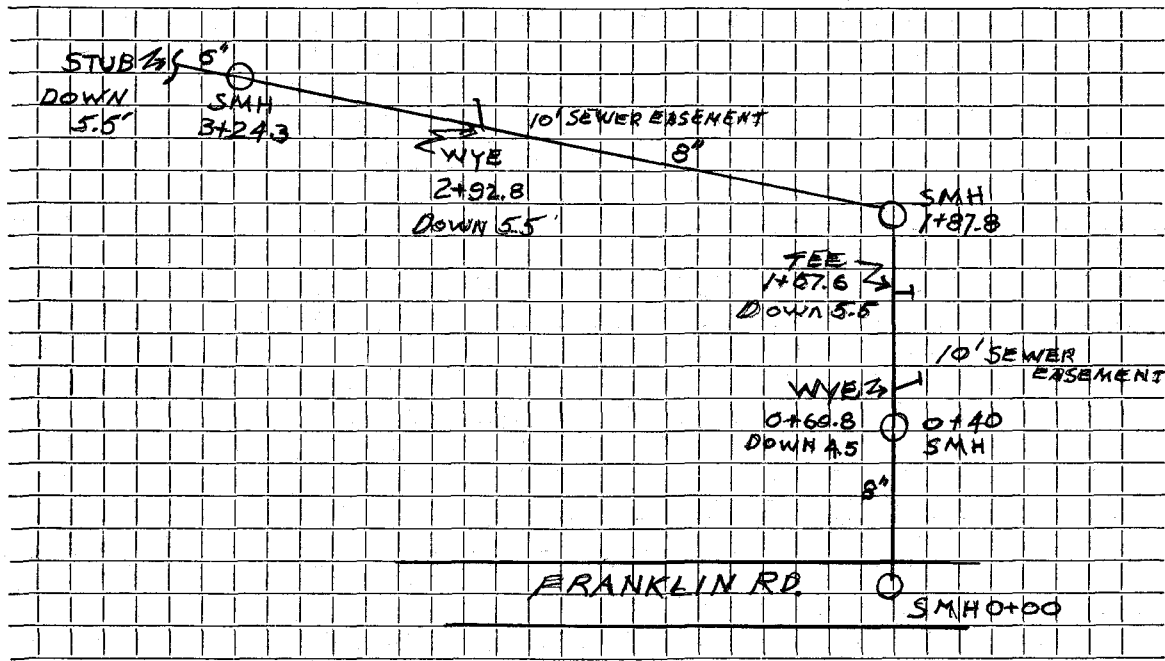

Connection made in Street. Work completed

Remarks:
.....
.....