

Name Charles Kingsley Jr.

Service No. 191

Address 16 Franklin Rd.

Lexington

Location

Kind of Pipe

Size

Size of Main

~~Repair~~ ~~Renewal~~ - New Service

Com. 12-29-52

Location

Date	Material	Amount	Total	Date	Amount
12/11/52	Labor	59 46		12-5-52 Deposited	150 00
12/16/52	Labor	14 00		12-29-52 Referred	(18 75
	10% Overhead	7 35	80 81		131 25
	72'-6" Sewer Pipe @.342		24 62		
	Joint Compound		4 32		
	4 Hrs. Town Shovel @5.00		20 00		
	2 Hrs. Trucking		1 50		
			131 25		
	Labor				

TOWN OF LEXINGTON—DEPT. OF PUBLIC WORKS

SEWER DIVISION

DATE

NO.

The undersigned applies for the construction of a particular sewer connecting No. Street and hereby agrees to comply with the Rules and Regulations governing the construction and use of Particular Sewers, as now or at any future time established by the Board of Selectmen.

Am't of estimate \$.....


Am't Paid \$.....

#16 Franklin
Ed.

Owner

Sketch of Service Here

16

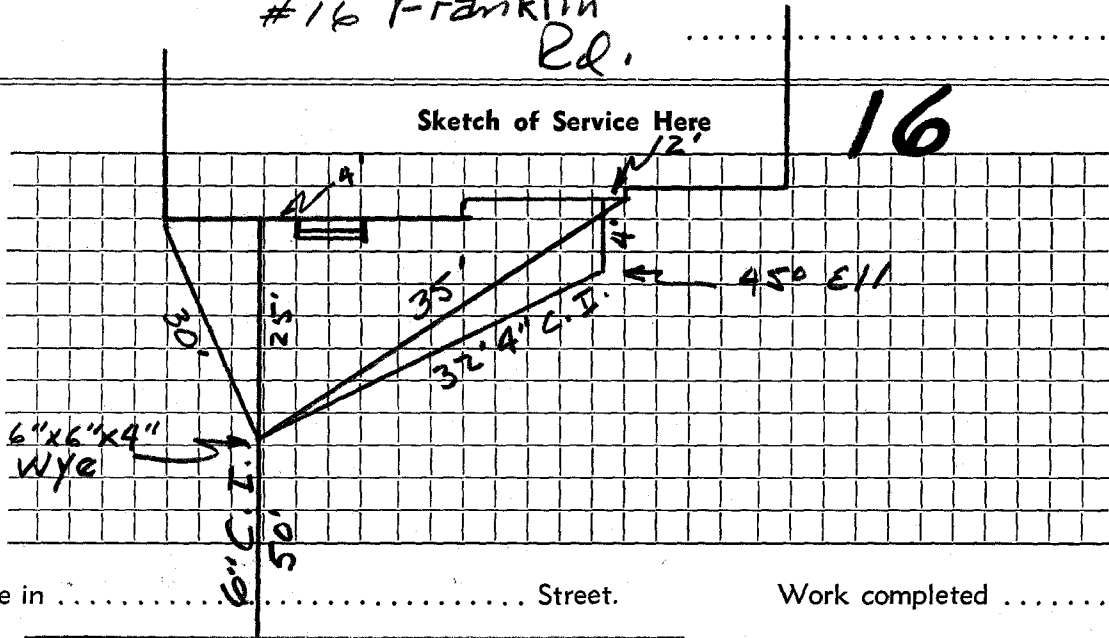

Connection made in Street.

Work completed 19..

Remarks:

MAIN