

Name Paul V. Roberts

Service No. 31

Address 17 Franklin Road

Location

Kind of Pipe

Size

Size of Main

~~Repair-Renewal~~ New Service

COM. 5-3-54

Location

Date	Material	Amount	Total	Date	Amount
4/16/54	Labor	54 89		3-29-54	150 00
	10% overhead	5 49	60 38	5-4-54	(8 50
	60'-6" Sewer pipe @.3087		18 52		141 50
	Joint compound		3 60		
	7-2/3 hr. Littlefield shovel @ 7.50		57 50		
	2 hr trucking @ .75		1 50		
			141 50		
	Labor				

TOWN OF LEXINGTON—DEPT. OF PUBLIC WORKS
SEWER DIVISION


DATE.....

NO.

The undersigned applies for the construction of a particular sewer connecting No.....
Street and hereby agrees to comply with the Rules and Regulations governing the construction and use of Particular
Sewers, as now or at any future time established by the Board of Selectmen.
Am't of estimate \$.....
Am't Paid \$.....

..... Owner

Sketch of Service Here

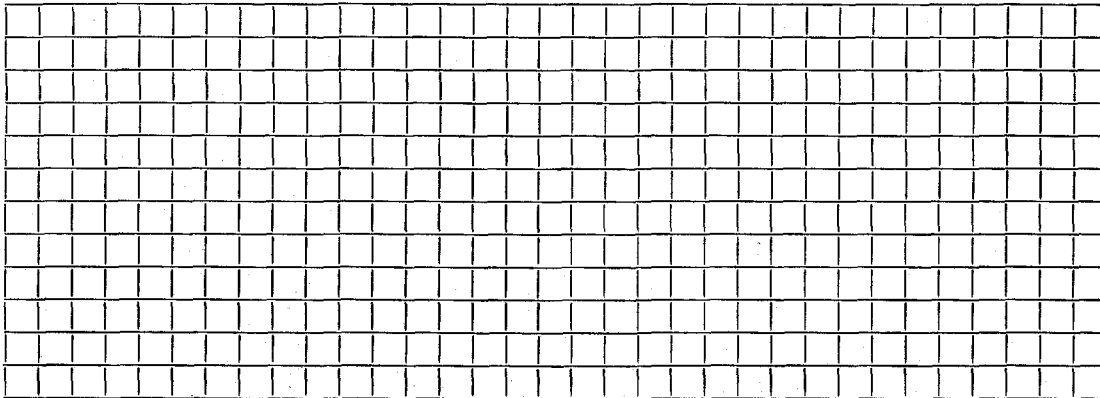

Connection made in..... Street.

Work completed.....19..

Remarks: