


MASSACHUSETTS

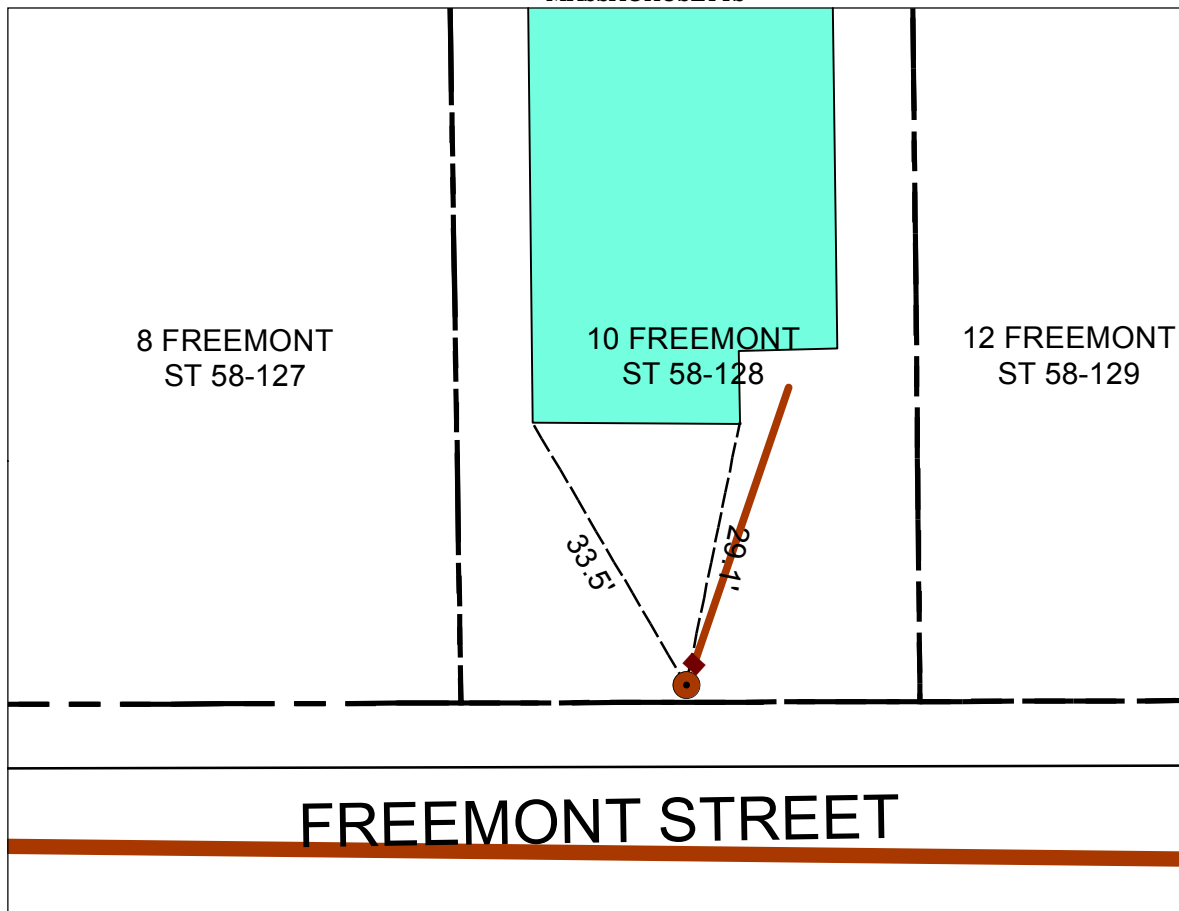

Address	Map and Lot	Permit Number	Contractor Name	Inspector
10 Freemont	90-87	5767	McLaughlin, James M. Inc.	dpavlik msprague
Date	Material	Depth of Cover	Amount	
9/15/2014	6x6 AC to PVC Fern Co	6.0 ft	1-Connect to existing stub	
	11 degree Bend	6.0 ft	1	
	6" PVC Pipe - SDR 35	8.0 ft	28 Feet	
Type of work completed				

New 6" PVC sewer service installed to new house, connection to existing stub.