

Name Eugene E. Moloy

Service No. 107

Address 15 Fremont St.

Location

Kind of Pipe

Size

Size of Main

Repair—Renewal—New Service W O # 7472


Location Comm 10-29-62

Date	Material	Amount	Total	Date	Amount
7/17/62	Labor	24 75		7-16-62	Deposit 100 00
	10% O.H.	2 48		10-29-62	ReFund 21 84
			27 23		28 16
	44' 6" Transite pipe @ .82		36 08		
	1 11 1/4" Transite elbow		2 35		
	1 hr. Town shovel @ 6.50		6 50		
	1 hr. trucking @ 3.00		3 00		
	1 hr. loader @ 3.00		3 00		
			78 16		

DATE \_\_\_\_\_

TOWN OF LEXINGTON — BOARD OF PUBLIC WORKS  
SEWER DIVISION

Sketch of Service Here **15**

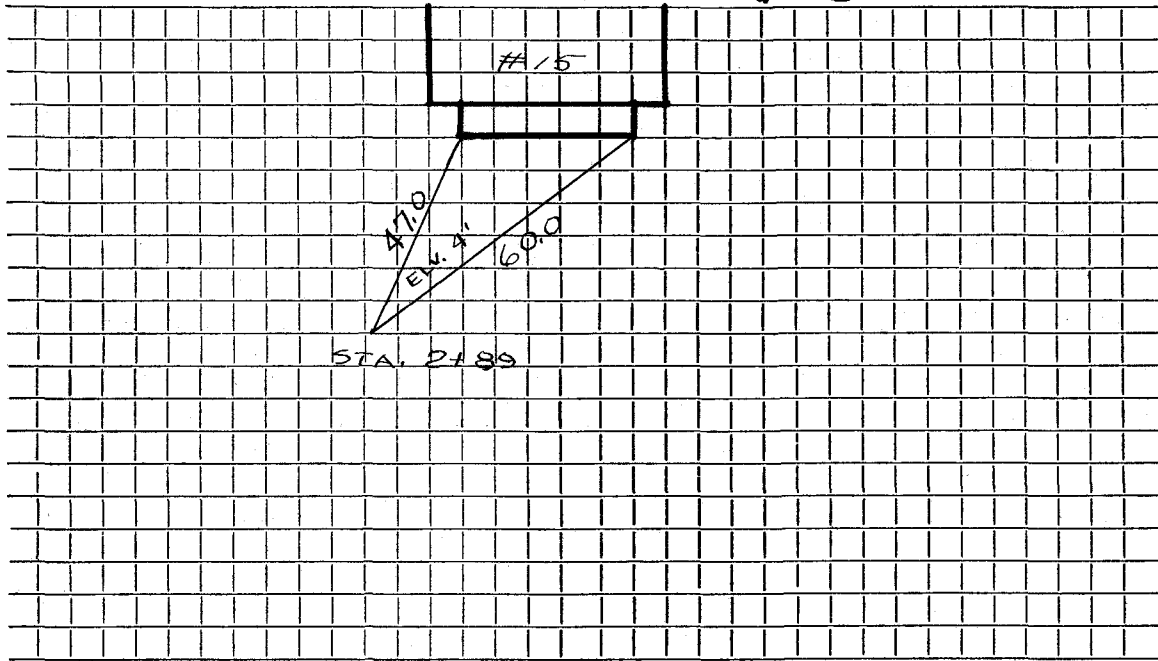

Connection made in ..... Street. Work completed .....

Remarks: .....  
.....  
.....