

Name Donald L. Cruwys

Service No. 107

Address 16 Freemont Street

Lots 167-168 Sta.3+90 left

Location

Kind of Pipe

Size

Size of Main


~~Renewal~~ New Service Russell Sibley Permit #38

Location *Comm 9-21-64*

Date	Material	Amount	Total	Date	Amount
9-13-63	Labor	59.41		7-2-64	115.09
	10% O.H.	5.94	65.35		
	20' 6" Transite piep @.82		16.40		
	1 90° Transite Elbow		4.09		
	1 6" Service Saddle		5.25		
	2 hrs. Town Shovel @6.50		13.00		
	2 hrs. Trucking @3.00		6.00		
	1 hr. Loader @5.00		5.00		
7-6-64	27' 6" A.C. Pipe		115.09		

DATE _____

TOWN OF LEXINGTON — BOARD OF PUBLIC WORKS
SEWER DIVISION

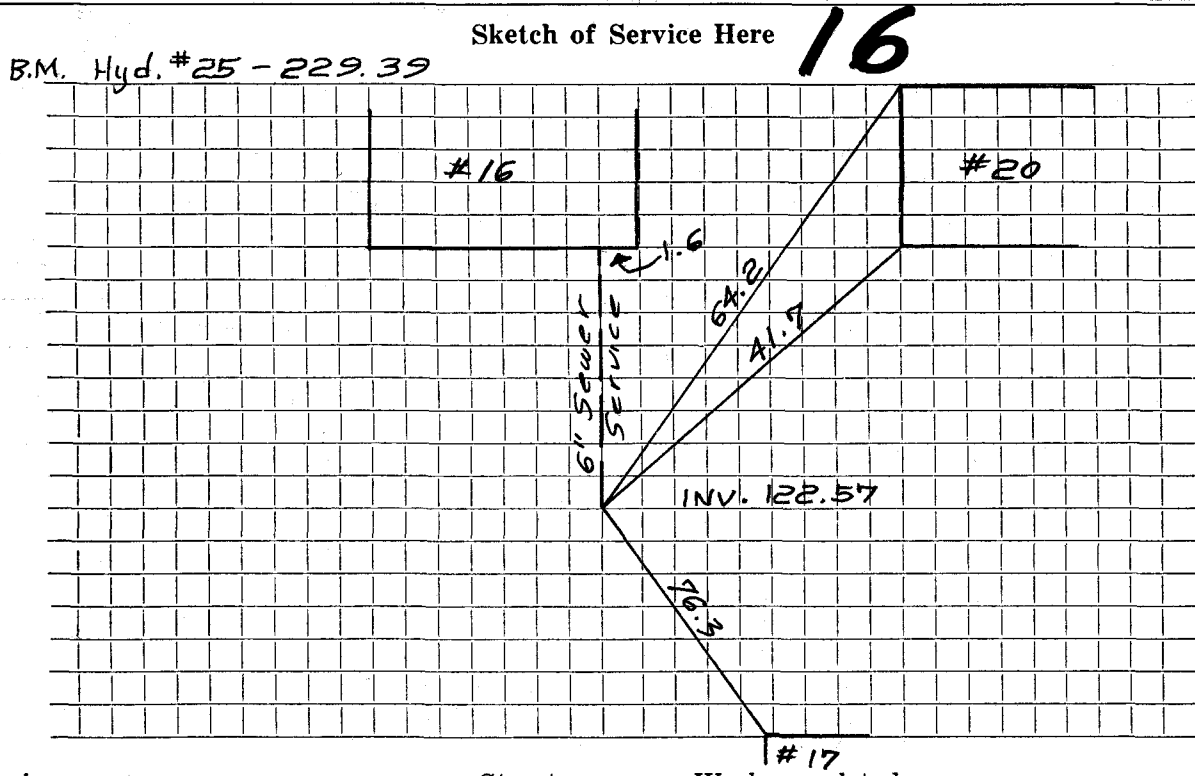

Connection made in Street. Work completed

Remarks:
.....
.....