

Name John Bullock

Service No. 210

Address 33 Freemont Street

Location

Kind of Pipe

Size

Size of Main

~~REPAIR SERVICE~~ New Service

Location *Conn 12-31-59*


Date	Material	Amount	Total	Date	Amount
10-27-59	Labor	60.13		<i>11-20-59</i>	<i>Deposit 150.00</i>
	10% O.H.	6.01	66.14	<i>12-31-59</i>	<i>Refund 14.82</i>
	60' 6" Transite pipe @.70		42.00		<i>135.18</i>
	1 90° Transite Elbow		5.29		
	3 hrs. Town Shovel @6.50		19.50		
	3 hrs. Trucking @.75		2.25		
			<u>135.18</u>		

DATE \_\_\_\_\_

TOWN OF LEXINGTON — BOARD OF PUBLIC WORKS

SEWER DIVISION

Sketch of Service Here **33**

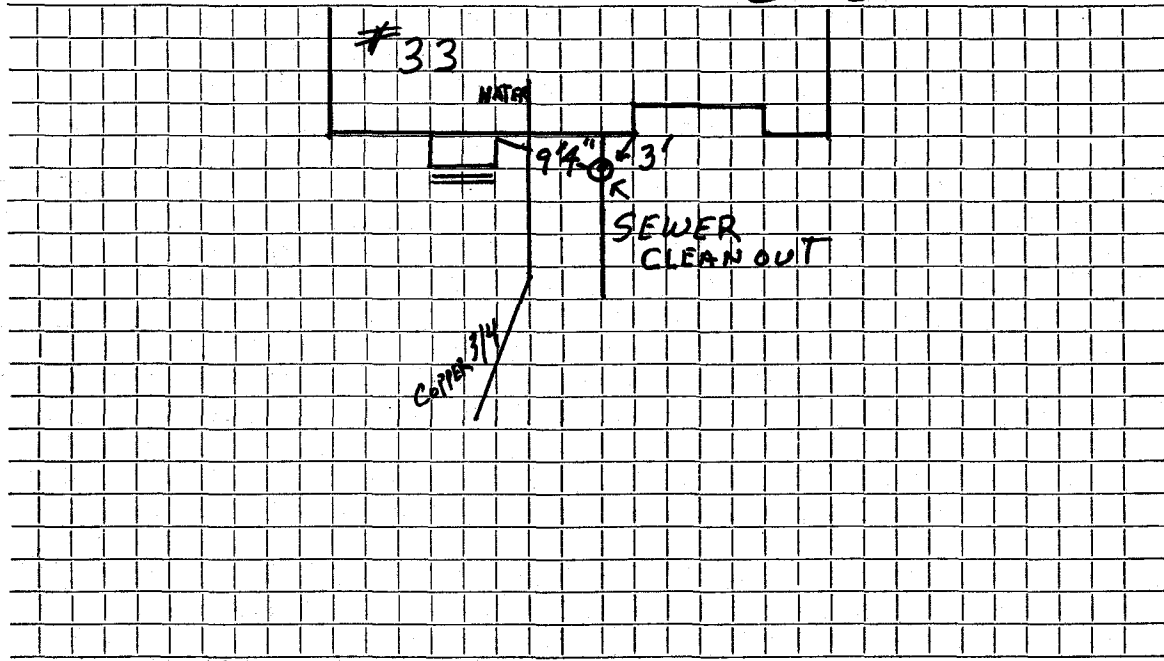

Connection made in ..... Street. Work completed .....

Remarks: CLEAN OUT 6" OUT FROM HOUSE. PIPE IS 2' DEEP COMING OUT OF HOUSE .....