

Name John Bullock

Service No. 211

Address 37 Freemont Street

Location

Kind of Pipe

Size

Size of Main

~~Repair~~ ~~Renewal~~ ~~XXXXXX~~ New Service

Location *Can 2-8-60*


Date	Material	Amount	Total	Date	Amount
10-23-59	Labor	26 74		11-20-59	Deposit 150 00
10-24-59	"	93 60		2-8-60	Paid by WHC#223 7 32
		120 34		2-8-60	Paid by WHC#222 22 85
	10% O. H.	12 03	132 37	5-11-60	Paid 19 60
55'	6" Transite pipe @.70		38 50		199 77
1	6" Adapter		1 90		
3	Hrs. Town Shovel @6.50		19 50		
1	Hr. Trucking @3.00		3 00		
2	Hrs. Trucking @.75		1 50		
1	Hr. Rogers Trailer @3.00		3 00		
			199 77		

Bill sent 2-8-60 19.60

DATE _____

TOWN OF LEXINGTON — BOARD OF PUBLIC WORKS
SEWER DIVISION

Sketch of Service Here

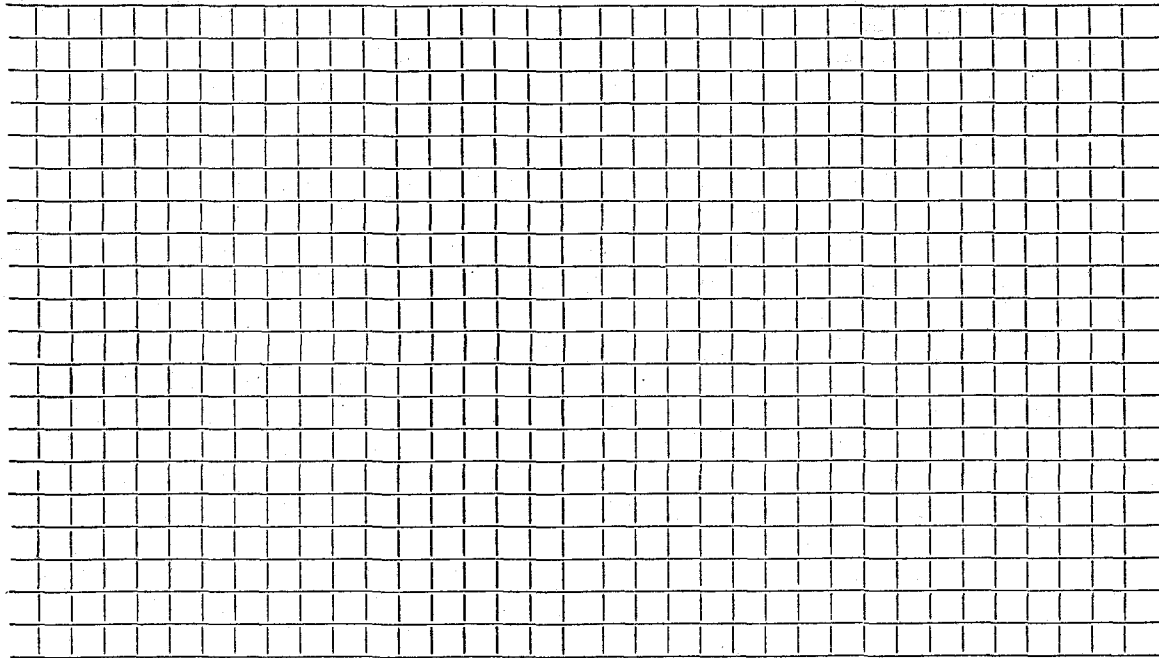

Connection made in Street. Work completed

Remarks:
.....
.....