

Name Mrs. W. J. Peyton

Service No. 227

Address 40 Fremont St.

Location

Kind of Pipe

Size

Size of Main

~~Repair - Renewal~~ New Service

Location Cam 2-29-60

Date	Material	Amount	Total	Date		Amount
12-14-59	Labor 28.86			11-16-59	<i>Deposit</i>	150 00
12-15-59	" 83.37	112.23		5-16-60	<i>Paid</i>	82 03
	10% O.H.	11.22	123.45			<u>232 03</u>
	25' 6" Transite pipe @.70		17.50			
	11' 6" Cast Iron Pipe @2.09		22.99			
	1 6" 90° Transite Elbow		5.29			
	1 11 1/4" Transite Bend		5.10			
	46 ton fill @.70		32.20			
	3 hrs. Town Shovel @6.50		19.50			
	8 hrs. Trucking @.75		6.00			
			<u>232.03</u>			

*Bill sent 2-29-60 82.03*


DATE \_\_\_\_\_

TOWN OF LEXINGTON — BOARD OF PUBLIC WORKS

SEWER DIVISION

Sketch of Service Here

40

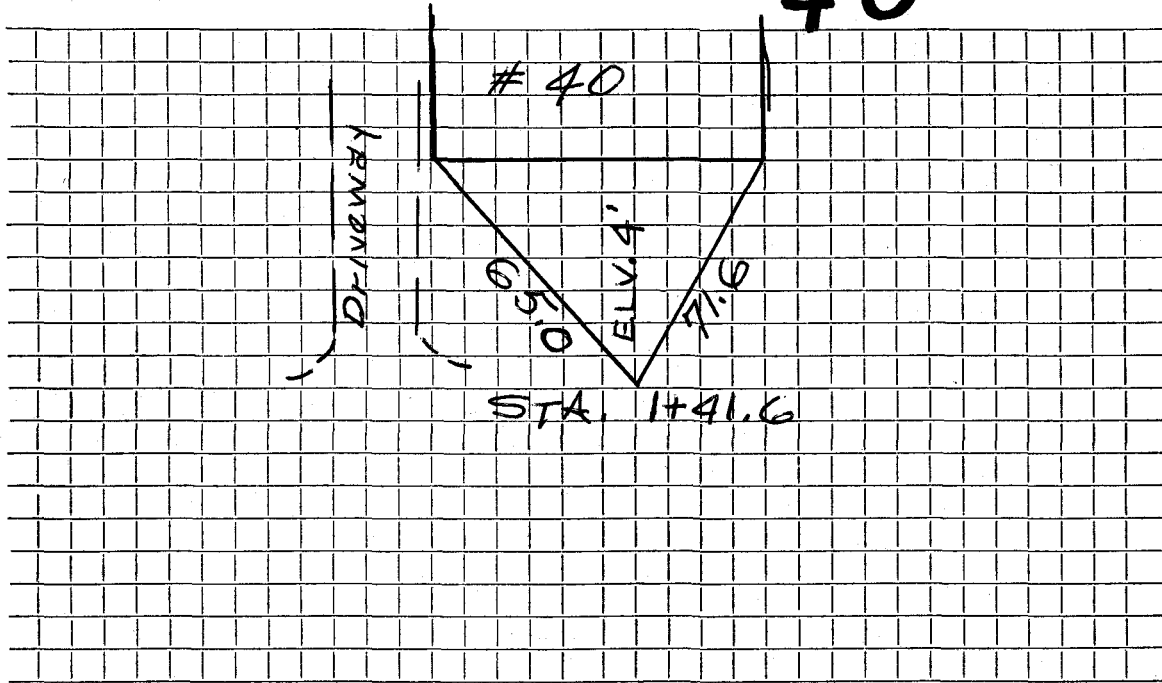

Connection made in ..... Street. Work completed .....

Remarks: .....  
.....  
.....