


TOWN OF LEXINGTON — BOARD OF PUBLIC WORKS
SEWER DIVISION

DATE 5/4/21

Sketch of Service Here

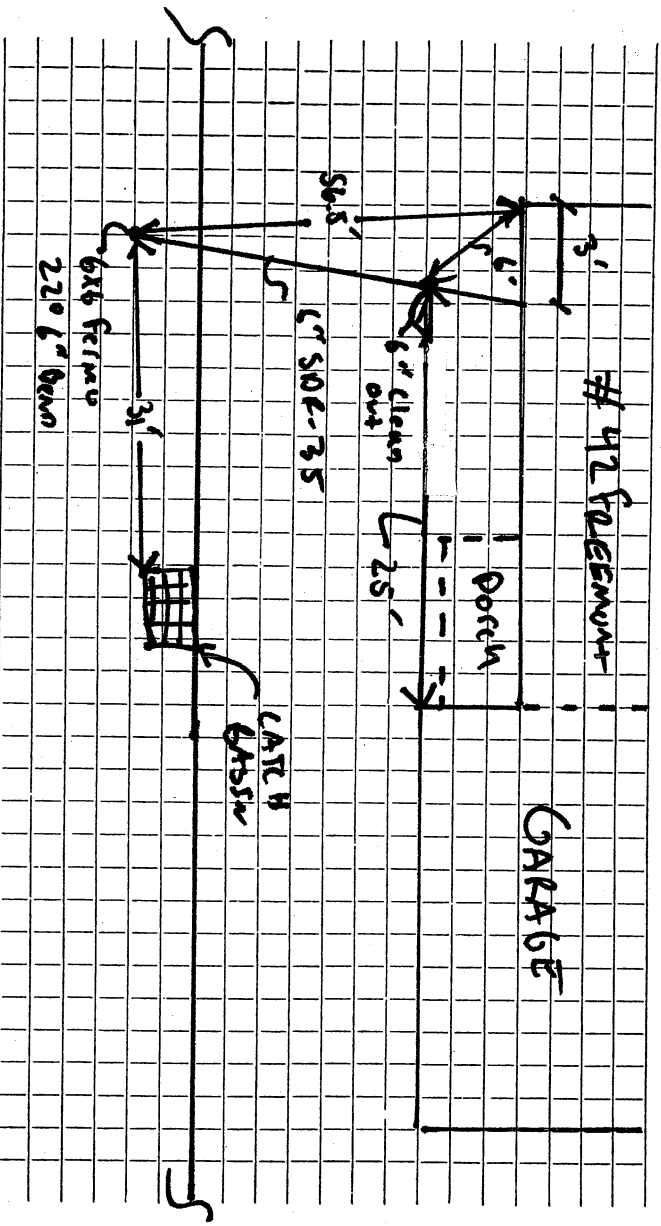

Connection made in Foremont Street. Work completed in ROW
 Remarks: X Connected into existing AC stub in ROW

