

Name John Bullock

Service No. 212

Address 43 Freemont St.

Location

Kind of Pipe

Size

Size of Main

~~Repair - Renewal~~ - New Service

Location Comm 2-8-60


Date	Material	Amount	Total	Date	Amount
10-27-59	Labor	15 50		11-20-59	Deposit 150 00
10-29-59	"	63 73		2-8-60	Paid by W.H.C. #273 13 68
		79 23			163 68
	10% O. H.	7 92	87 15		
	60' 6" Transite pipe @.70		42 00		
	1 11 $\frac{1}{4}$ " Transite Elbow		2 24		
	1 6" 90° Transite Elbow		5 29		
	3 Hrs. Town Shovel @6.50		19 50		
	2 Hrs. Trucking @.75		1 50		
	1 Hr. Rogers Trailer @3.00		3 00		
	1 Hr. Trucking @3.00		3 00		
			163. 68		

DATE _____

TOWN OF LEXINGTON — BOARD OF PUBLIC WORKS

SEWER DIVISION

Sketch of Service Here

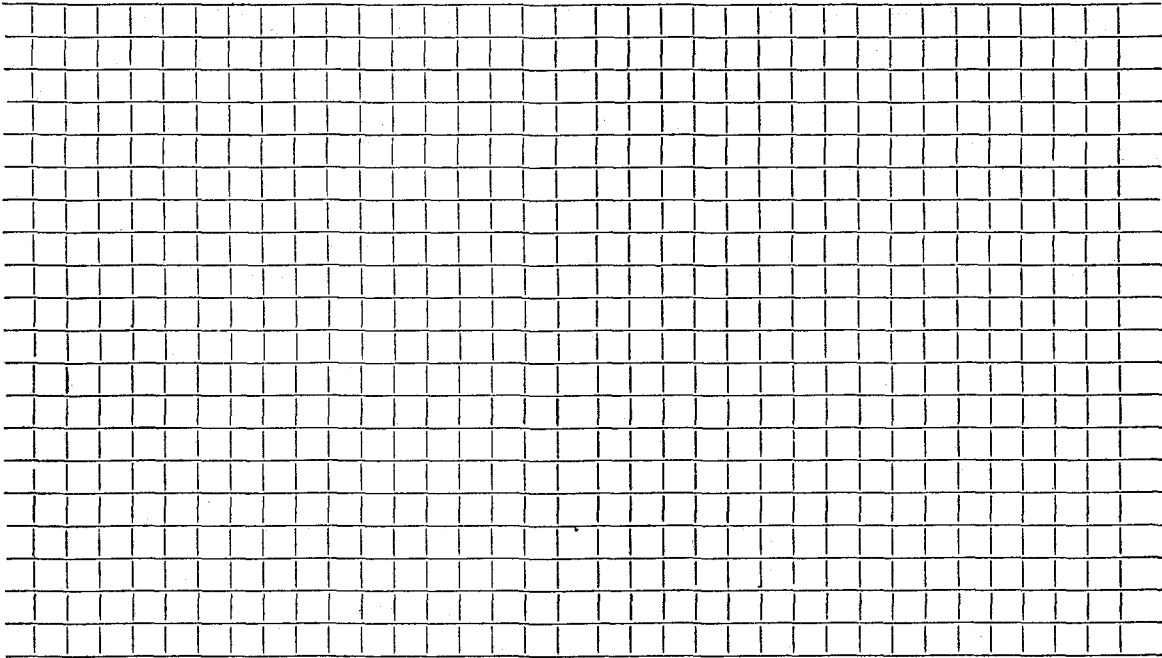

Connection made in Street. Work completed

Remarks:
.....
.....