

Name Cyril Pratt

Service No. 80

Address 44 Freemont Street

Lots 630-634 Sta. 8+0

Location

Kind of Pipe

Size

Size of Main

Repair—Renewal—New Service

Permit # 8 - John E Grant

Location Comm 5-18-64


Date	Material	Amount	Total	Date	Amount
9-9-63	Labor	78.61		5-5-64	Deposit
	10% O.H.	7.86	86.47		149.11
	24' 6" Transite pipe @.82		19.68		
	1 6" Service Saddle		5.25		
	1 90° Transite Elbow		4.09		
	1 Duplex Adapter		1.62		
	4 hrs. Town Shovel @6.50		26.00		
	2 hrs. Trucking @3.00		6.00		
	BILL WHEN CONNECTED		149.11		
4-29-64	Installed by Contractor John E. Grant to house				

DATE _____

TOWN OF LEXINGTON — BOARD OF PUBLIC WORKS

SEWER DIVISION

Sketch of Service Here **44**

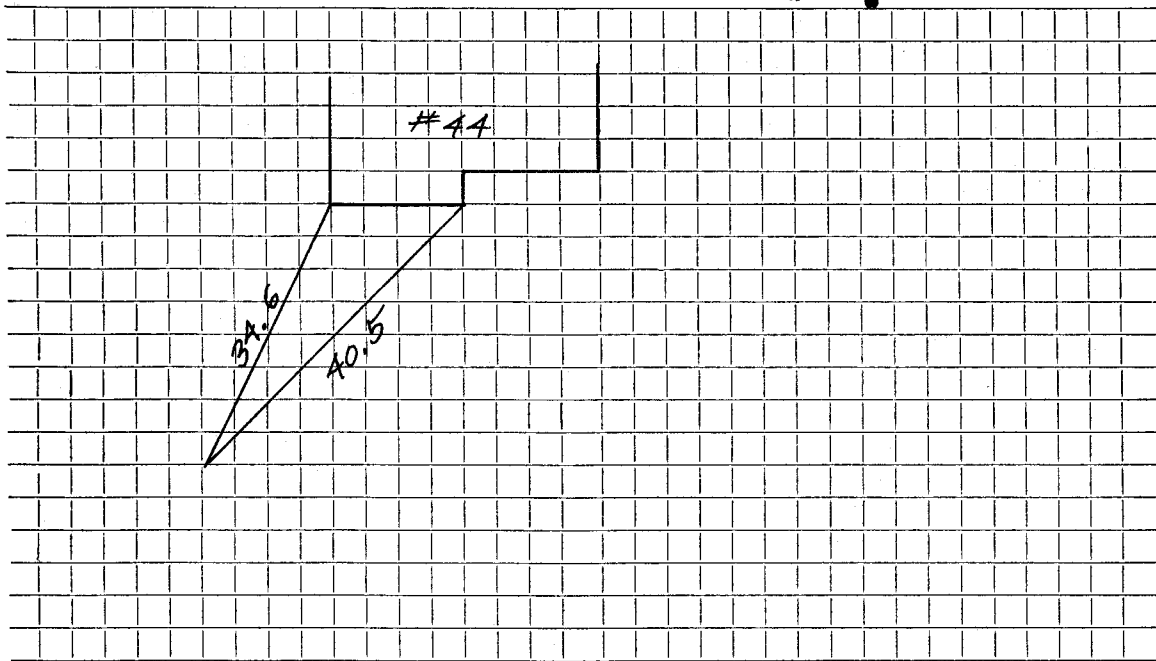

Connection made in Street. Work completed

Remarks:
.....
.....