

Name Paula Realty Trust

Service No. 184

Address 45 Fremont Street

Lots 212-213 Sta. 8+72

Location

Kind of Pipe DeFlice Bros

Size

Size of Main

~~Repair/Replacement~~ New Service Permit #154

Location DEC 28 1964

Date	Material	Amount	Total	Date	Amount
9/5/63	Labor	46 74		11-6-64	98 18
	10% O.H.	4 67	51 41		
	15' Transite pipe @ .82		12 30		
	1 6" Sewer Cap		1 93		
	1 Service Saddle		7 04		
	3 hrs. Town Shovel @ 6.50		19 50		
	2 hrs. Trucking @ 3.00		6 00		
			98 18	12-11-04	Problem in MAIN piping roots 225' from MH # 315
11-19-64	33' 6" Transite pipe				


DATE _____

TOWN OF LEXINGTON — BOARD OF PUBLIC WORKS
SEWER DIVISION

45

Sketch of Service Here

BM Steps #43 - 222.65

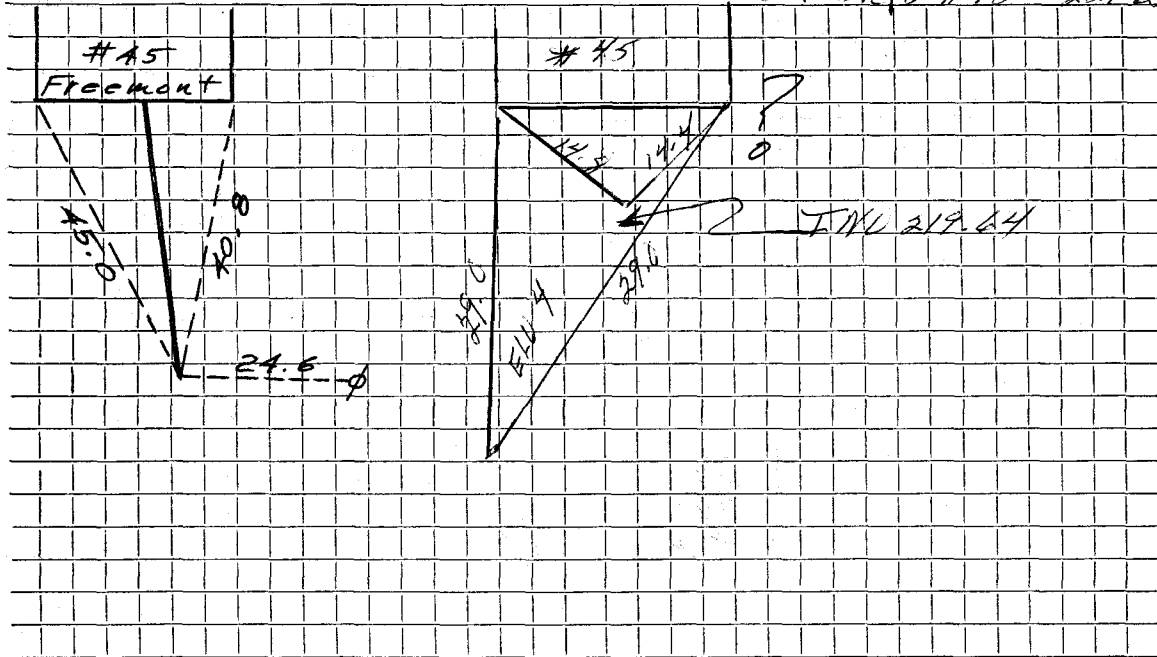

Connection made in Street. Work completed

Remarks:

.....

.....