

Name Paula Realty Trust

Service No. 28

Address #49 Fremont St.

Lots 215 - 217 Sta. 9+45

Location

Kind of Pipe

Size

Size of Main

~~Repair - Renewal - New Service~~ DeFlice Bros. Permit #234

Location MAY 17 1965

Date	Material	Amount	Total	Date	Amount
9-13-63	Labor	22.60		4-8-65	103.18
9-16-63	"	24.92	47.52		
	10% O.H.		4.75		
	26' 6" Transite pipe @.82		21.32		
	1 22 ¹ / ₂ " Transite bend		4.09		
	3 hrs. Town Shovel @6.50		19.50		
	2 hrs. Trucking @3.00		6.00		
			103.18		
5-12-65	30' 6" Transite pipe				

DATE _____


TOWN OF LEXINGTON — BOARD OF PUBLIC WORKS

SEWER DIVISION

48

Sketch of Service Here

B.M. Hyd opp. Asbury St.
229.98

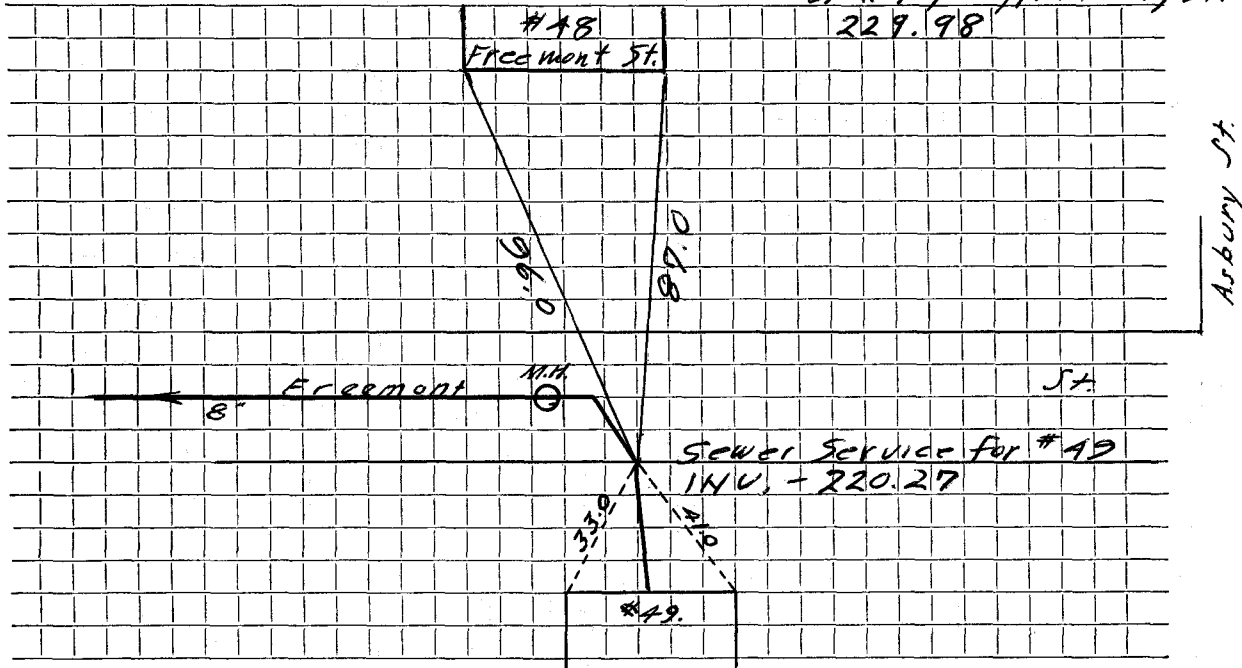

Connection made in Street. Work completed

Remarks:
.....
.....