

Name Paula Realty Trust

Service No. 58

Address 53 Freemont Street

Location

Kind of Pipe

Size

Size of Main

~~Repair - Renewal~~ New Service W.O. #8041

Location Comm 10-28-63


Date	Material	Amount	Total	Date	Amount
6-28-63	Labor 83.66			6-24-63	Deposit 250 00
7-1-63	" 26.48	110 14		10-28-63	Refund 51 15
	10% O.H.	11 01	121 15		198 85
60'	6" Transite pipe @.82		49 20		
3	Hrs. Town Shovel @6.50		19 50		
3	Hrs. Trucking @3.00		9 00		
			198 85		

DATE _____

TOWN OF LEXINGTON — BOARD OF PUBLIC WORKS
SEWER DIVISION

Sketch of Service Here

53

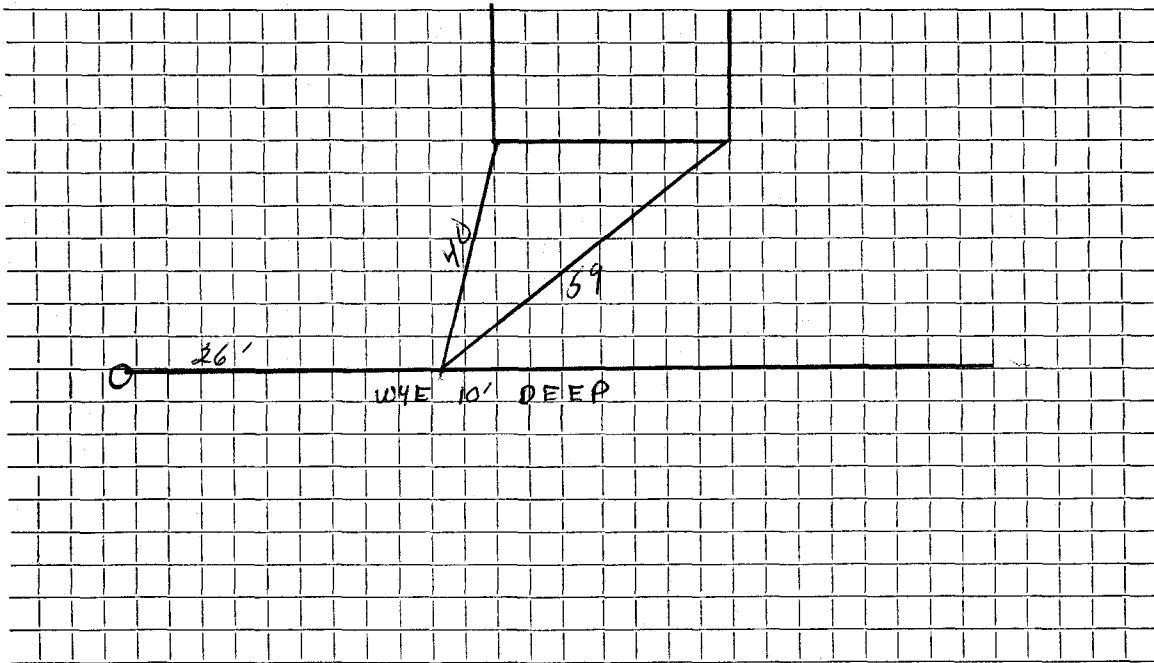

Connection made in Street. Work completed

Remarks:
.....
.....