

Name Edward Balke

Service No. 113

Address 59 Fremont Street

Location

Kind of Pipe

Size

Size of Main

~~Repair~~ ~~Renewal~~ New Service


Location *Camden 8-1-60*

Date	Material	Amount	Total	Date	Amount
7-7-60	Labor	92 69		<i>6-27-60</i>	<i>Deposit 200 00</i>
	10% O.H.	<u>9 27</u>	101 96	<i>8-1-60</i>	<i>Paid by WMA 5 20</i>
	75' 6" Transite pipe @78		58 50		<i>205 20</i>
	1 6" 90° Transite Elbow		5 40		
	1 22 $\frac{1}{8}$ " Transite Elbow		2 24		
	1 11 $\frac{1}{4}$ " Transite Bend		5 10		
	4 Hrs Town Shovel @6.50		26 00		
	2 Hrs Trucking @3.00		<u>6 00</u>		
			205 20		

DATE _____

TOWN OF LEXINGTON — BOARD OF PUBLIC WORKS
SEWER DIVISION

Sketch of Service Here **59**

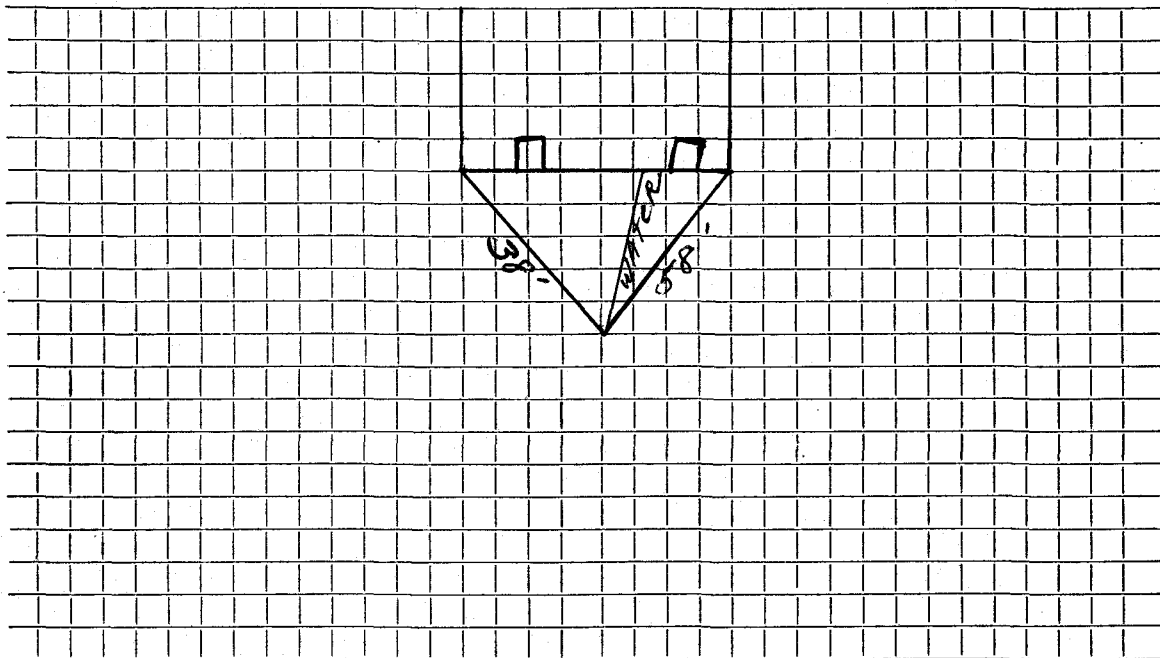

Connection made in Street. Work completed

Remarks:
.....
.....