

Name Allan F. Kenney

Service No. 47

Address 6 Fremont St.

Location

Kind of Pipe

Size

Size of Main

~~Repair~~ New Service

Location Conn 6-19-41


| Date | | Material | Amount | Total | Date | | Amount |
|---------|-----|------------------------|--------|---------------|---------|----------|--------|
| 5-16-61 | | Labor | 56.05 | | 5-11-61 | Deposit | 200.00 |
| | | 10% O.H. | 5.61 | 61.66 | 1-14-61 | Retained | 83.52 |
| | 39' | 6" Transite pipe @.78 | | 30.42 | | | 116.48 |
| | 1 | 90° Transite Elbow | | 5.40 | | | |
| | 2 | Hrs. Town Shovel @6.50 | | 13.00 | | | |
| | 2 | Hrs. Trucking @3.00 | | 6.00 | | | |
| | | | | <u>116.48</u> | | | |

DATE _____

TOWN OF LEXINGTON — BOARD OF PUBLIC WORKS

SEWER DIVISION

Sketch of Service Here

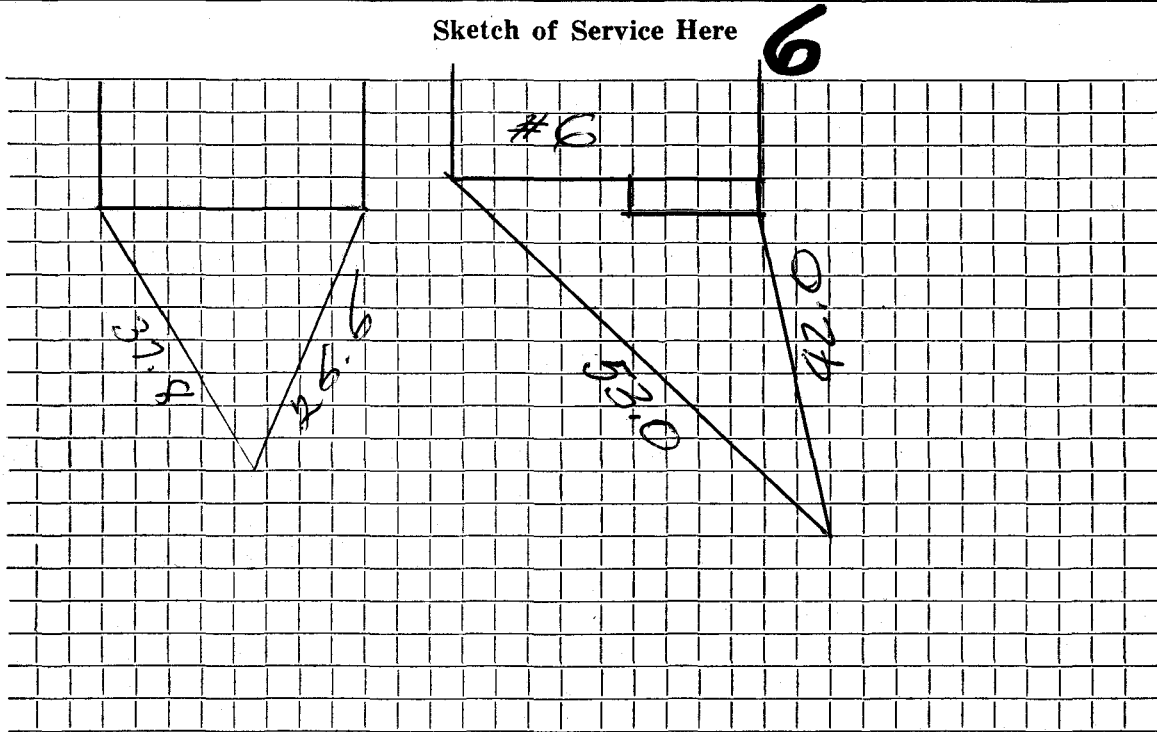

Connection made in Street. Work completed

Remarks:

.....

.....