

Name

Service No.

Address #60 Fremont St.

Location

Kind of Pipe

Size

Size of Main

Repair—Renewal—New Service

Location

Date

Material

Amount

Total

Date

Amount

9-16-63

20' 6" Transite


1 6"-90° Elbow

DATE _____

TOWN OF LEXINGTON — BOARD OF PUBLIC WORKS

SEWER DIVISION

Sketch of Service Here **60** B.M. Steps #63 - 215.67

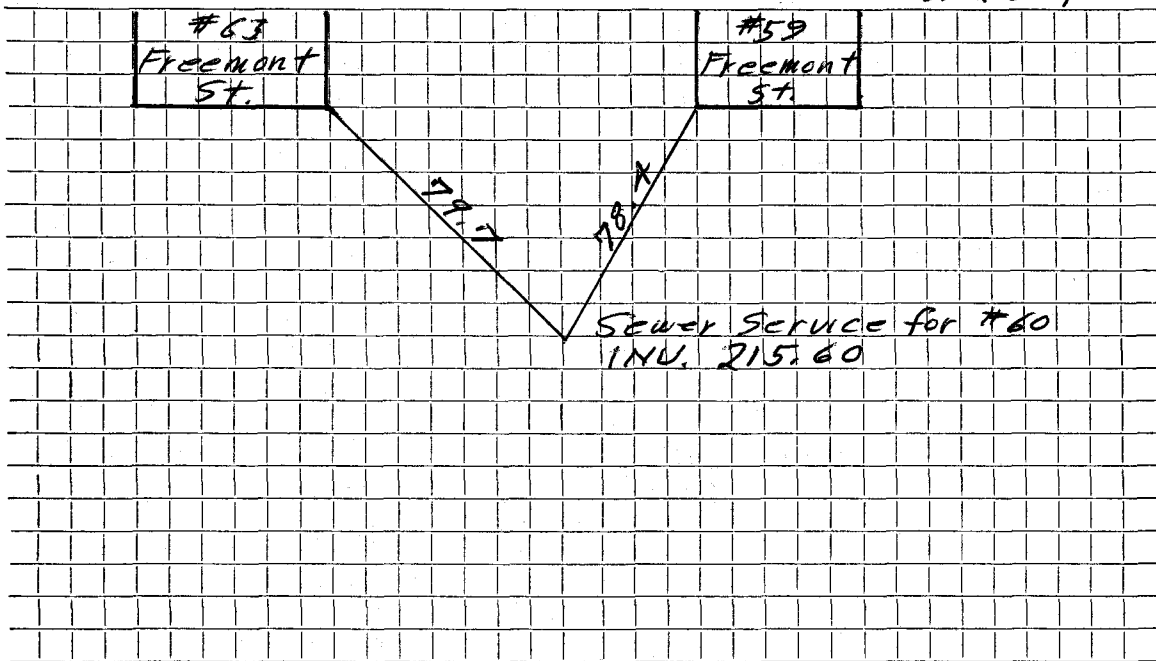

Connection made in Street. Work completed

Remarks:
.....
.....