

Name Truman JamesService No. 2Address 62 Fremont StreetLots 234-237Sta. 12+50

Location

Kind of Pipe

Size

Size of Main

Repair—Renewal—New Service WO# 8461Location MAR 23 1964

Date	Material	Amount	Total	Date	Amount
9-17-63	Labor	55.73		1-6-64	Deposit 200.00
	10% O.H.	5.57	61.30	3-23-64	Retained 30.82
	20' 6" Transite pipe @.82		16.40		169.18
	2 hrs. Town Shovel @6.50		13.00		
	1 hr. Trucking @3.00		3.00		
	Bill When Connected		93.70		
1-10-64	Labor	23.43			
	10% O.H.	2.34	25.77		
	42' 6" Transite Pipe @.82		34.44		
	2 1 1/4° Transite Bends @4.09		8.18		
	1 22 1/2° Transite Bends		4.09		
	1 Hr. Trucking @3.00		3.00		
			169.18		

DATE _____


TOWN OF LEXINGTON — BOARD OF PUBLIC WORKS

SEWER DIVISION

62

Sketch of Service Here

B.M. Steps #63 215.67

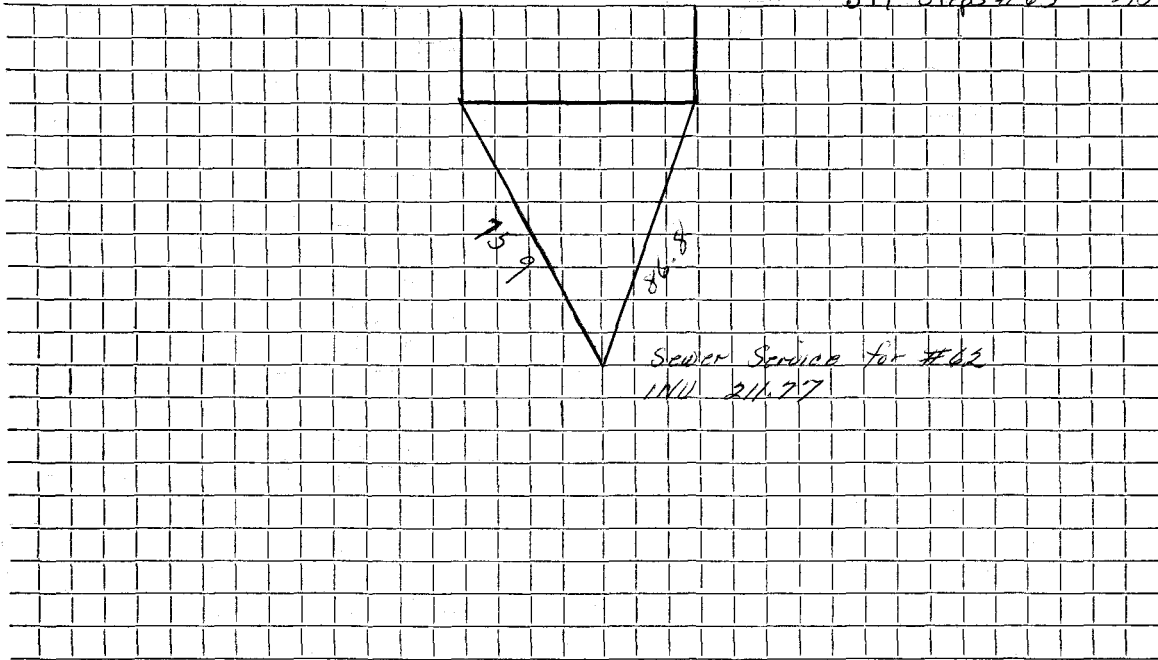

Connection made in Street. Work completed

Remarks:

.....

.....