

Name Leeland Const. Co.

Service No. 247

Address 71 Freemont Street

Location

Kind of Pipe

Size

Size of Main

~~Repair - Renewal~~ New Service

Location


CANA 2-25-60

Date	Material	Amount	Total	Date		Amount
12-14-59	Labor	42.88		12-1-59	Deposit	200.00
	10% O.H.	4.29	47.17	1-29-60	Retained	39.12
	45' 6" Transite pipe @.70		31.50			110.88
1	6" 11 $\frac{1}{4}$ " Elbow		2.24	8-5-59	CONSTITUTION RD	
1	6" 11 $\frac{1}{4}$ " Bend		5.10		26' 6" TRANSITE	
3	hrs. Town Shovel @6.50		19.50			
1	hr. Trucking @3.00		3.00			
1	hr. Rogers Trailer @3.00		3.00			
2	hrs. Trucking @.75		1.50			
			113.01			
	PREVIOUS CHARGE		27.87			
			140.88			

DATE _____

TOWN OF LEXINGTON — BOARD OF PUBLIC WORKS
SEWER DIVISION

Sketch of Service Here

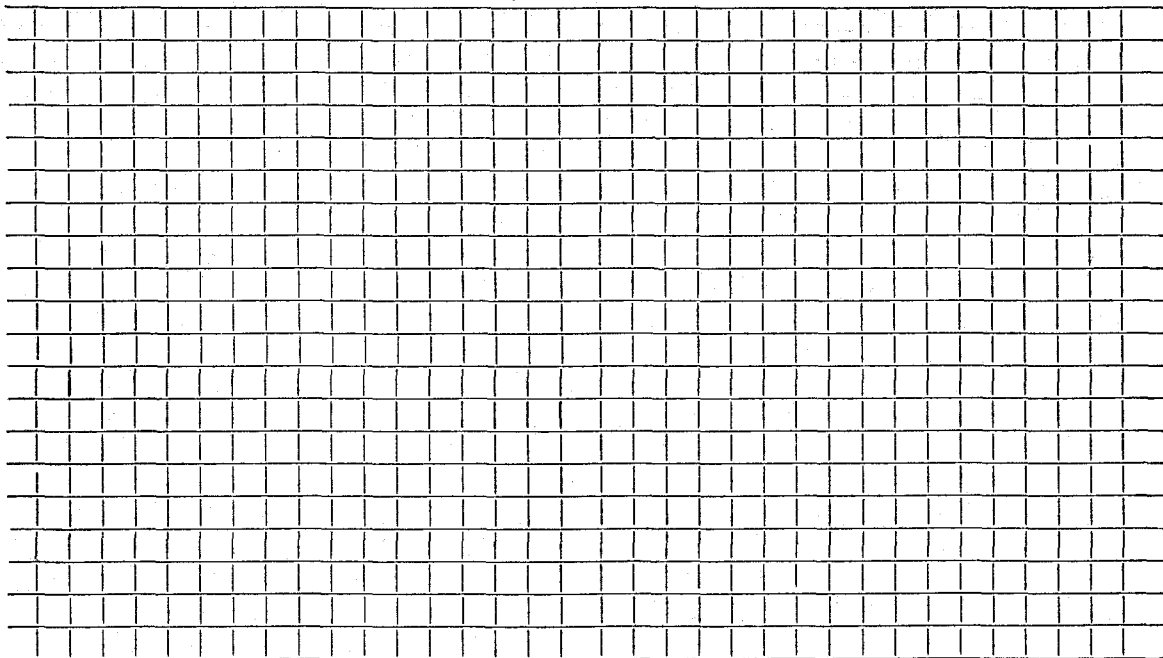

Connection made in Street. Work completed

Remarks:
.....
.....