

Name Leeland Construction

Service No. 16

Address 72 Fremont Street

Location

Kind of Pipe

Size

Size of Main

REPAIR WORK - New Service

Location Comm 6-19-61

Date	Material	Amount	Total	Date	Amount
4-25-61	Labor	16.18		3-30-61	Deposit 100 00
	10% O.H.	1.62	17.80	6-19-61	* Retain 43 68
	39' 6" Transite pipe @.78		30.42		56 32
	1 11 $\frac{1}{4}$ " Transite Bend		5.10		
	1 Hr. Trucking @3.00		3.00		
			<u>56.32</u>		

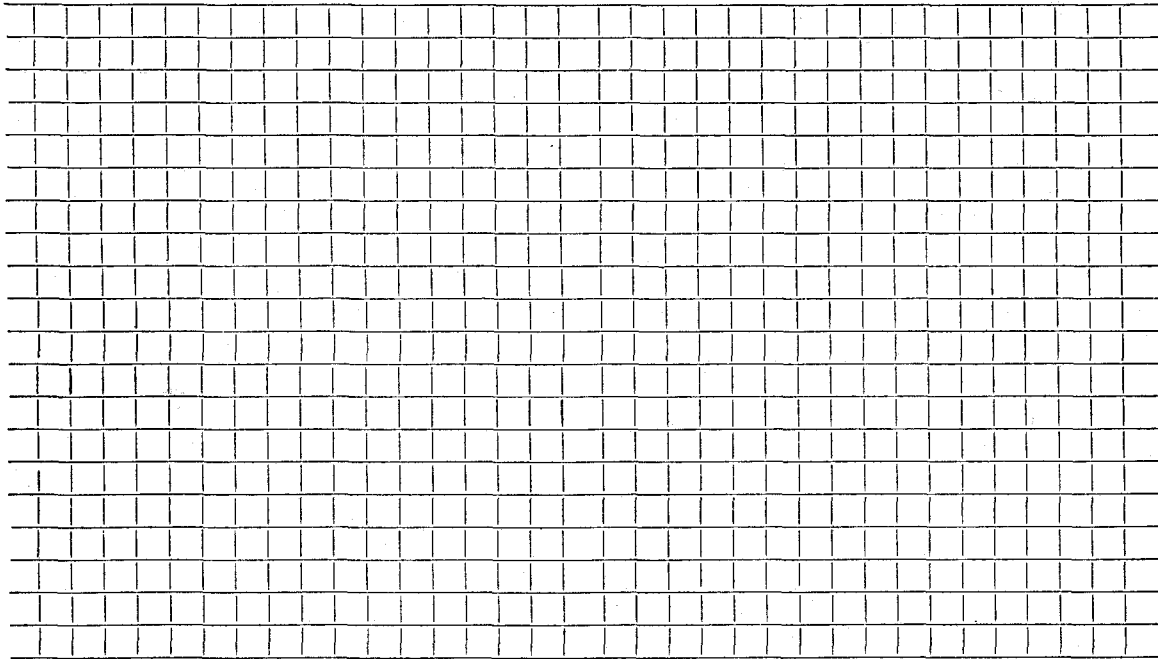
* Apply to WHC#16 39 39
 " SHC#15 4 29

DATE _____

TOWN OF LEXINGTON — BOARD OF PUBLIC WORKS

SEWER DIVISION

Sketch of Service Here

A large grid of graph paper, consisting of approximately 20 columns and 25 rows of small squares, intended for sketching service details.

Connection made in Street. Work completed

Remarks:
.....
.....