




DATE \_\_\_\_\_

TOWN OF LEXINGTON — BOARD OF PUBLIC WORKS  
SEWER DIVISION

Sketch of Service Here

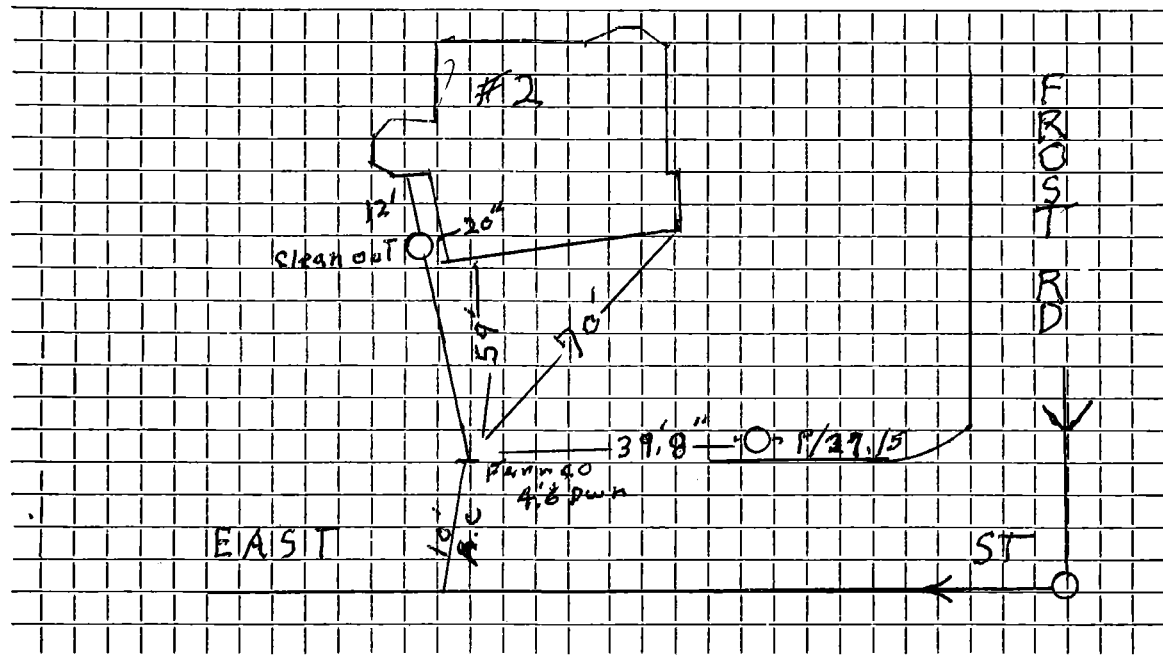

Connection made in East St ..... Street.      Work completed Feb 2012 .....

Remarks: .....

.....

.....