

Name William Burnham

Service No. 72

Address 4 Frost Road

W.O. #8705

Location

Kind of Pipe

Size

Size of Main

~~XXXXXXXXXX~~ New Service

Location


DEC 28 1964

Date	Material	Amount	Total	Date	Amount
6-8-64	Labor	57.92		4-30-64	300 00
7-3-64	"	135.73	193 65	1-5-65	44 47
	10% O.H.	19 37	213 02		364 47
72'	6" Transite Pipe @.82		59 04		
1	Bag Cement		1 50		
7½	Ton Sand @1.40		10 50		
2	11¼° Transite Bends @4.09		8 18		
2	22½° Transite Bends @4.09		8 18		
1	22½° Transite Elbow		2 35		
1	6" Adapter		1 90		
1	90° Transite Elbow		4 09		
1	12" Nipple		1 21		
6	Hrs. Trucking @3.00		18 00		
5	Hrs. Town Shovel @6.50		32 50		
1	Hr. Loader @4.00		4 00		
			364 47		Bill sent 64 47

DATE _____

TOWN OF LEXINGTON — BOARD OF PUBLIC WORKS
SEWER DIVISION

Sketch of Service Here

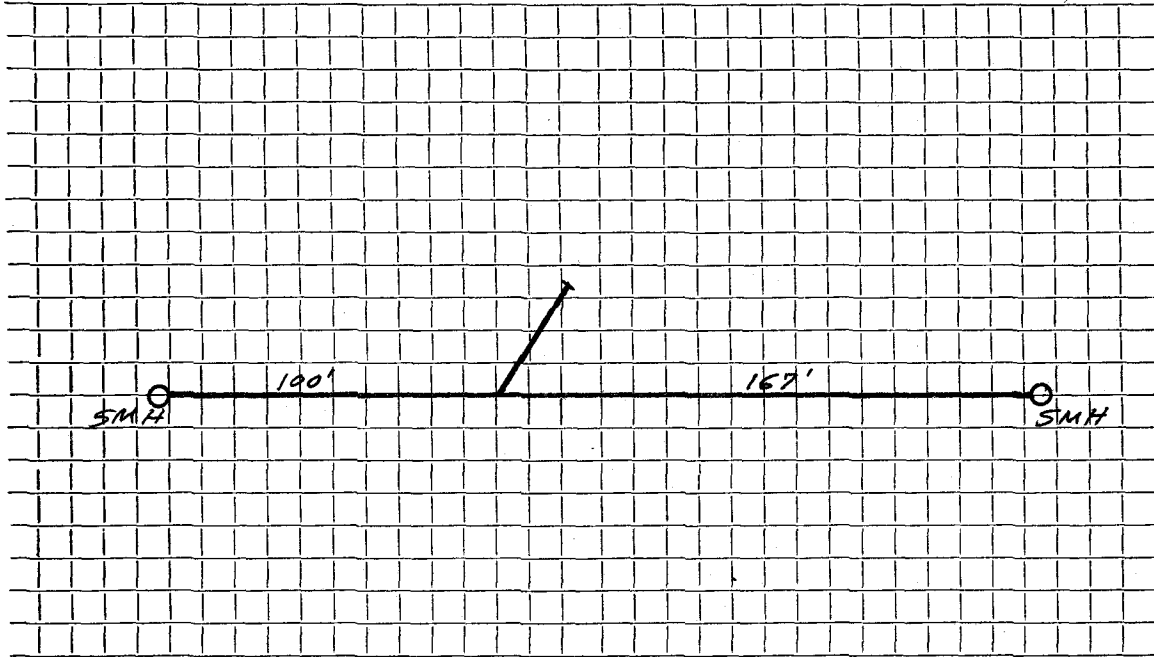

Connection made in Street. Work completed

Remarks:
.....
.....