

Name Moore Realty Trust

Service No.

Address 5 Frost Road

Lot 7

Location

Kind of Pipe

Size

Size of Main

~~Repair General~~ — New Service DeFlice Bros. Permit #120

Location


Date		Material	Amount		Total		Date		Amount	
1964	46'	6" Transite pipe								

DATE _____

TOWN OF LEXINGTON — BOARD OF PUBLIC WORKS

SEWER DIVISION

Sketch of Service Here **5**

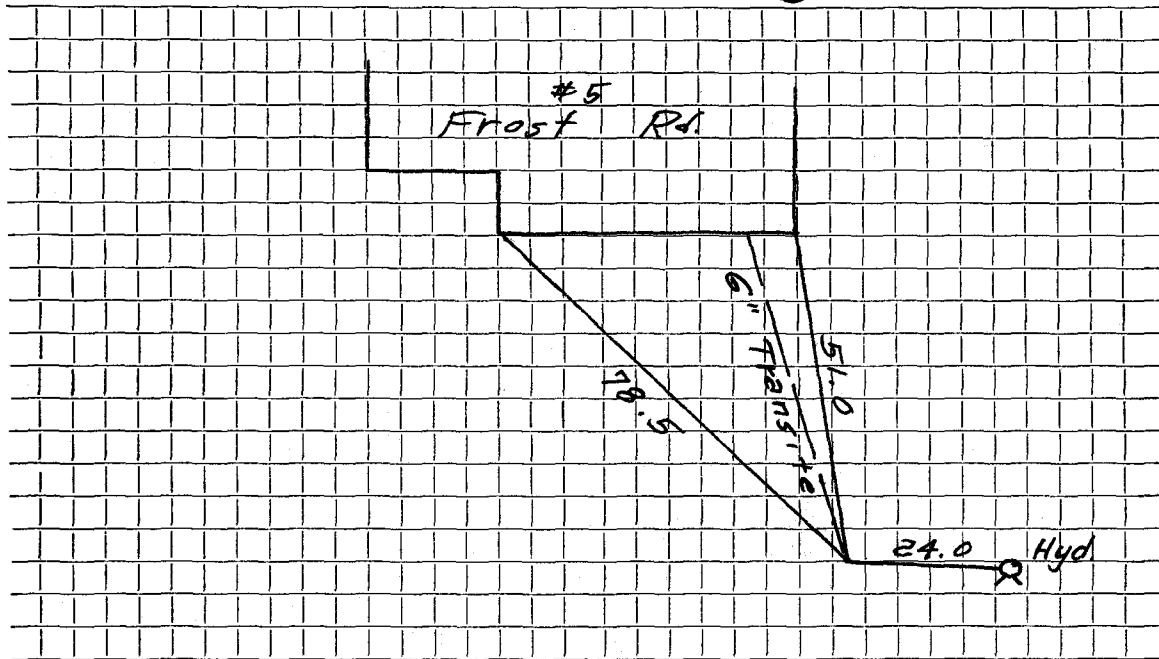

Connection made in Street. Work completed

Remarks:
.....
.....